
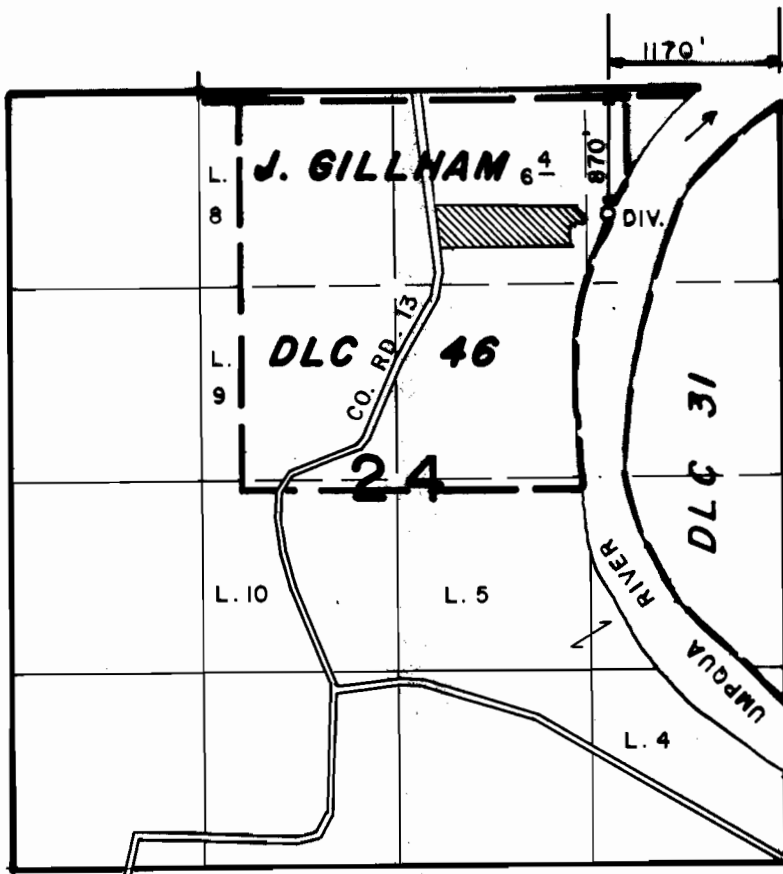


T. 26 S., R. 7 W., W.M.

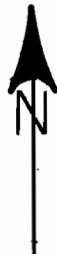

SCALE: 4" = 1 MILE  
**FINAL PROOF SURVEY**  
UNDER

Application No. 67773. Permit No. 48263  
IN NAME OF

**BERKLEY I. FREEMAN**

Surveyed MAY 17, 1988, by J.M. SCHMORDE.