


P-48222  
C-65536

T.14S., R.31E., W.M.

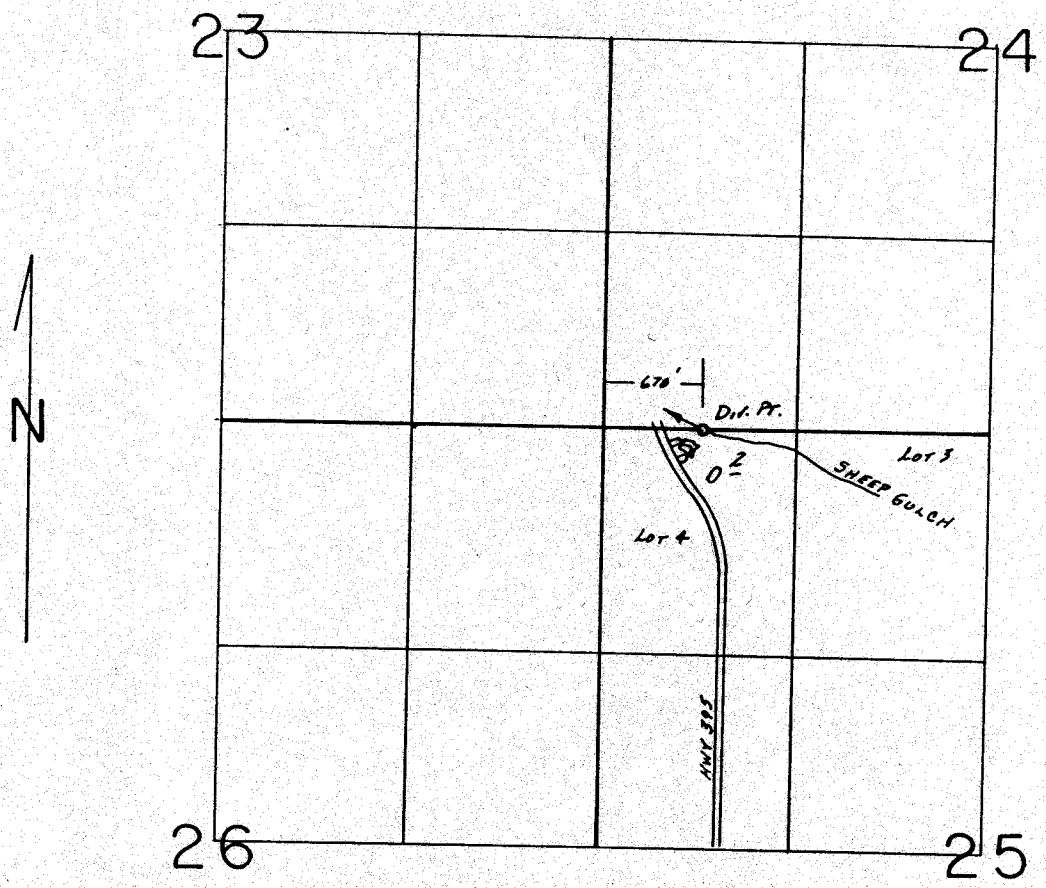

SCALE: 1" = 1320'

**FINAL PROOF SURVEY**  
UNDER

Application No. 67915.. Permit No. 48222.....  
IN NAME OF

.....CARL & DORTHA HOPPE.....

Surveyed June 17.. 1988, by Y.L. CHURCH.....