


T.18S., R.19E., W.M.

N

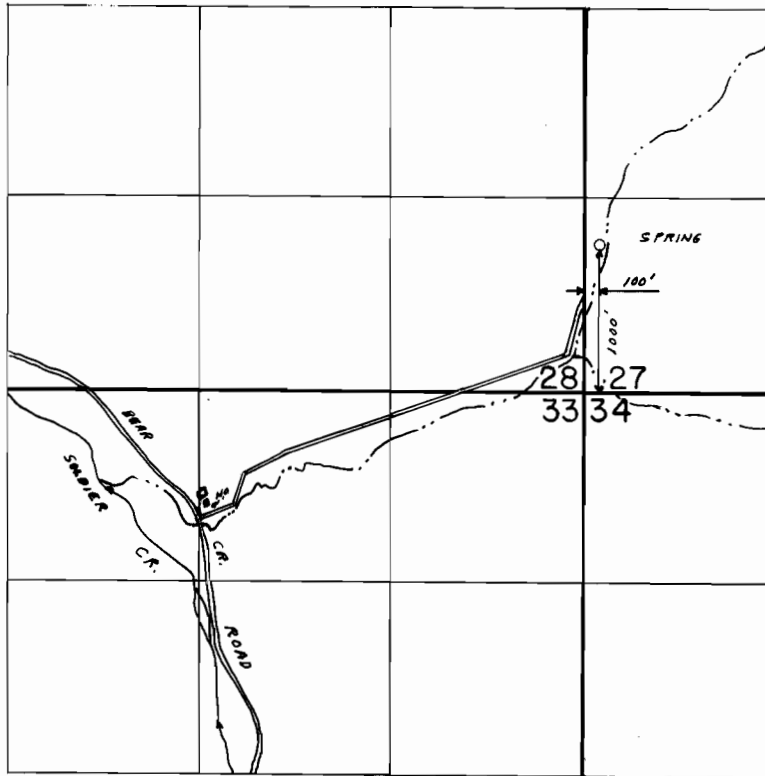

SCALE: 1" = 1320'

FINAL PROOF SURVEY
UNDER

Application No. 67917... Permit No. 48297...
IN NAME OF

CROOK COUNTY

Surveyed AUG...4... 19.88, by B. BISHOP

2-17-89

41013-280-250D

L.C.