
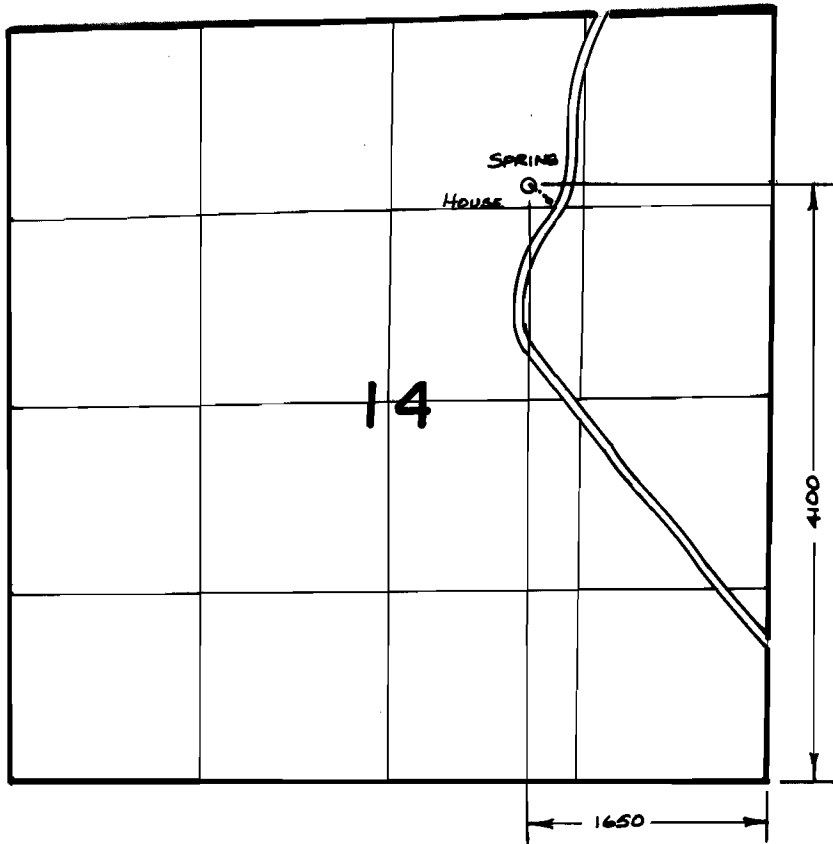


T. 28 S., R. 13 W., W.M.

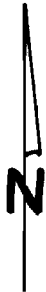

SCALE : 4" = 1 MILE

FINAL PROOF SURVEY
UNDER

Application No. ...67942. Permit No.48342....
IN NAME OF

.....**KAREN E. MORROW**.....

Surveyed ...3/17,.... 1988., by ...M..SCHMORDE..