
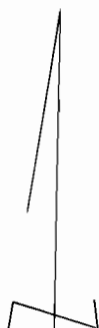


T. 5 & 6N., R. 43E., W.M.

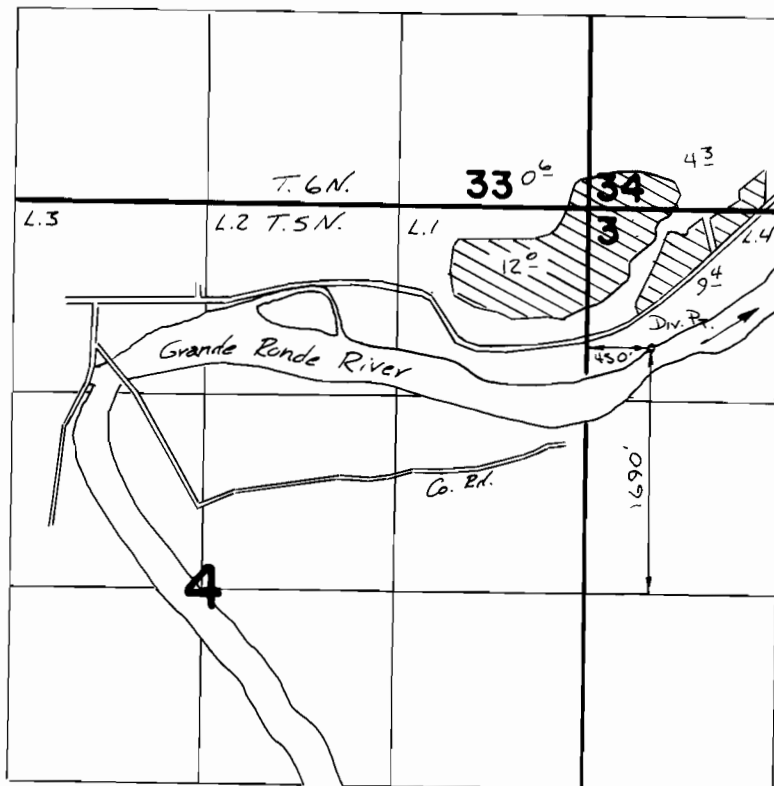

SCALE 1" = 1320'

FINAL PROOF SURVEY UNDER

Application No. **68067** Permit No. **48483**
IN NAME OF

OREGON DEPARTMENT OF FISH & WILDLIFE

Surveyed 8-16 1988, by K. KEMP