


T. 35 S., R. 14 W., W. M.

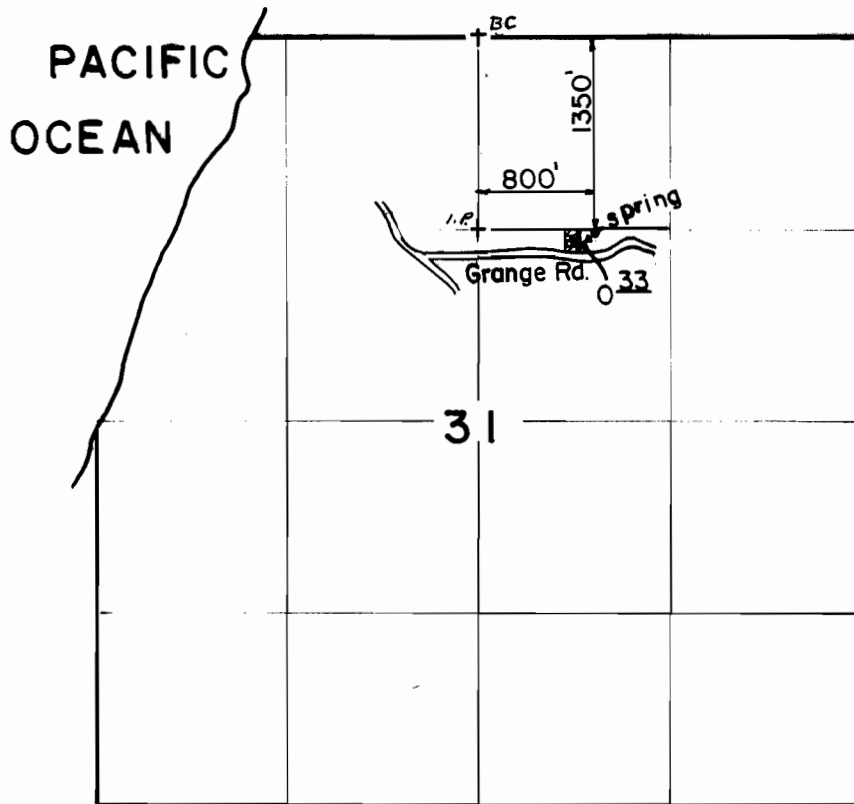

Scale: 1" = 1320'

FINAL PROOF SURVEY
UNDER

Application No. ~~68167~~ Permit No. ~~48958~~...
IN NAME OF

.....LOIS.....M.....BROOKS.....

Surveyed JUL...26.. 1988, by B...S...JAMES....