


T. 29 S., R. 9 W., W. M.

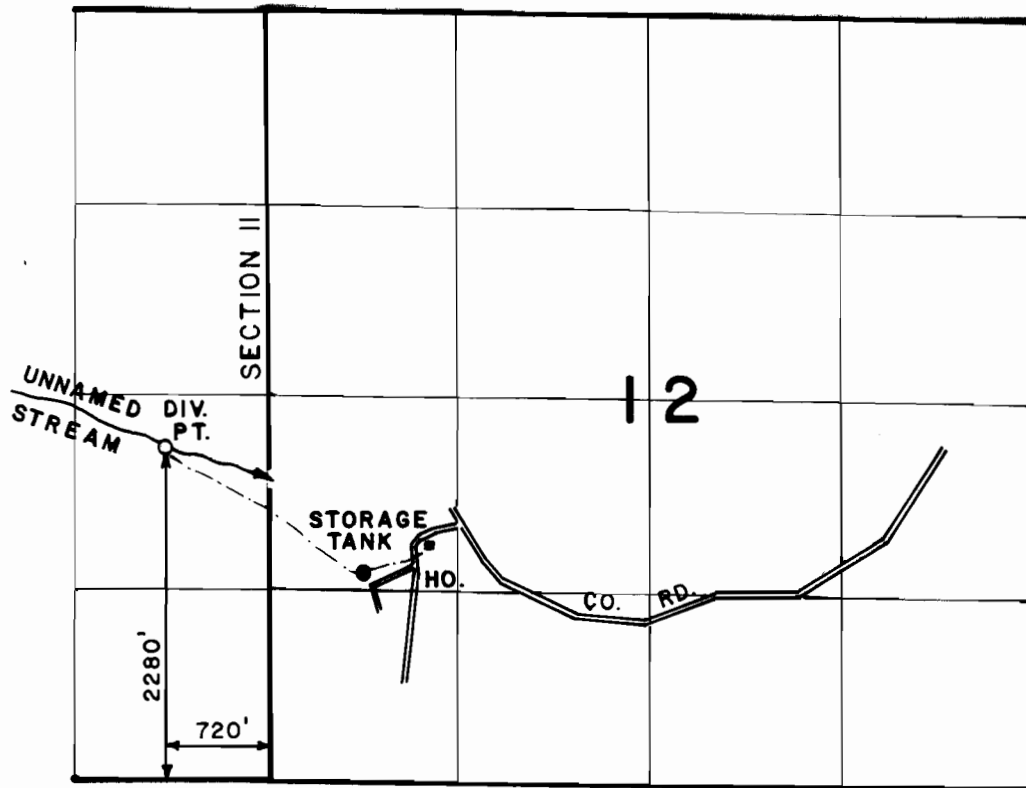

SCALE: 4" = 1 MILE

FINAL PROOF SURVEY
UNDER

Application No. 68184..... Permit No. 48877.....
IN NAME OF

JIMMY BENJAMIN RENTZ

Surveyed JUNE 22, 1988., by J.M. SCHMORDE