



T.7S. & T.8S., R.39E., W.M.

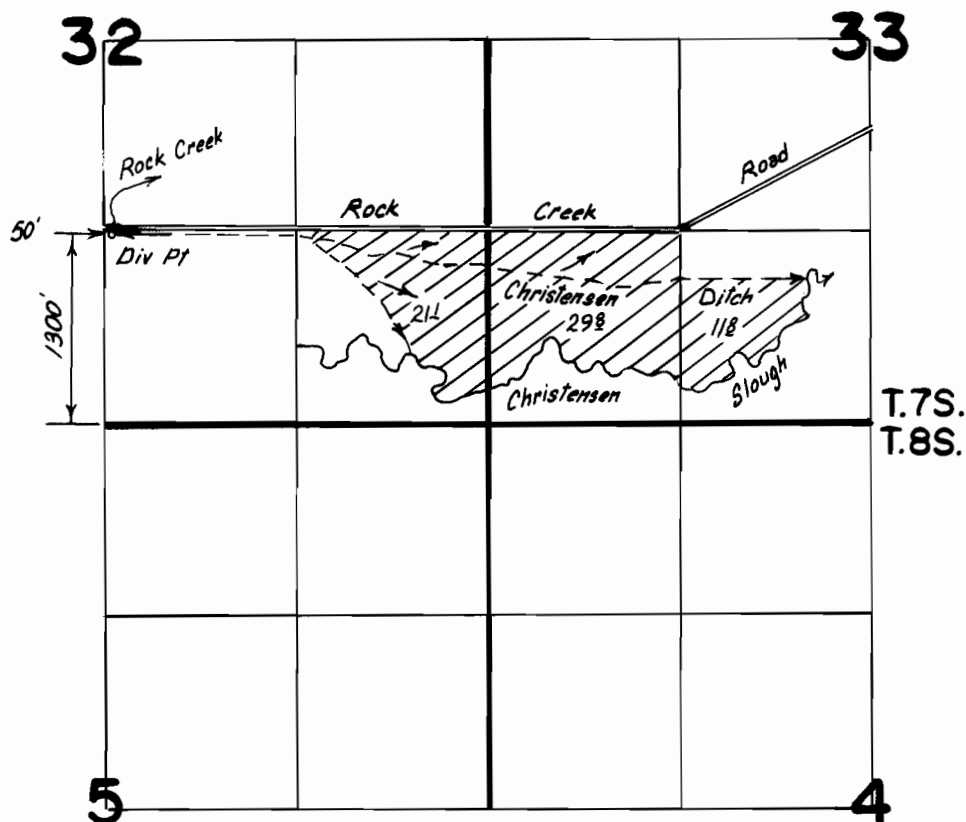

FINAL PROOF SURVEY UNDER

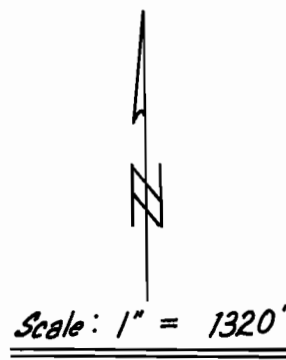

Application No. 68248 Permit No. 49385

IN NAME OF

JOHN C. MACK

Surveyed 4-3 1989, by Kenn Kemp