


T. 3 S, R. 4 W, W.M.

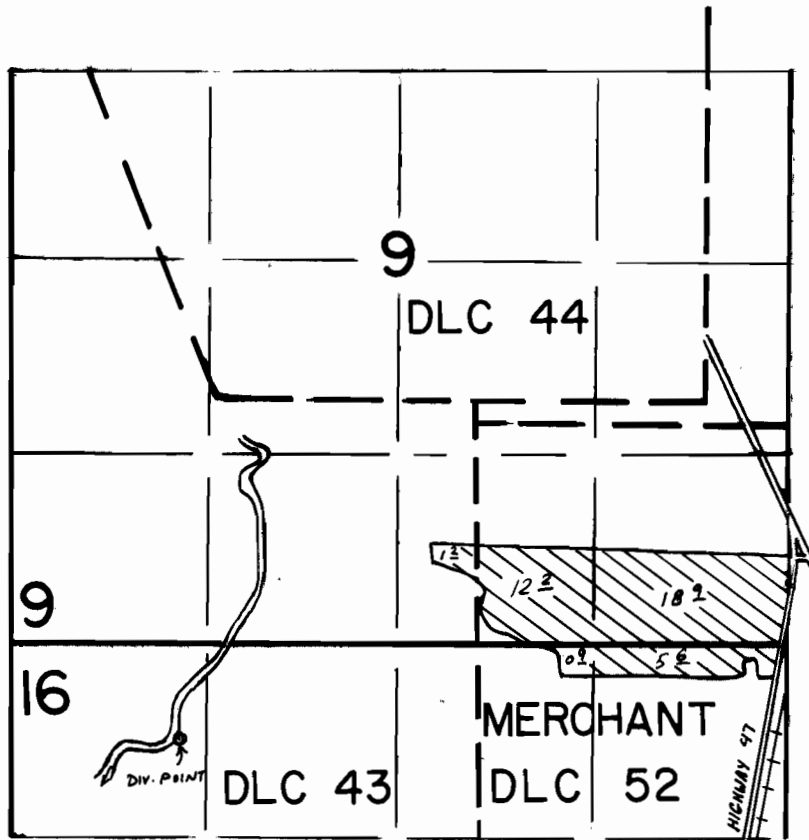

DIV. POINT : 1160' E & 650' S FROM NW CORNER SEC 16

SCALE 1" = 1320'

FINAL PROOF SURVEY UNDER

Application No. **68272**..... Permit No. **49232**.....
IN NAME OF

.....**DONALD**.....**POND**.....

Surveyed **SEP 29 88** by **Z. SALEH**

41071-178-62 D
12-14-88 Z.F.S.