
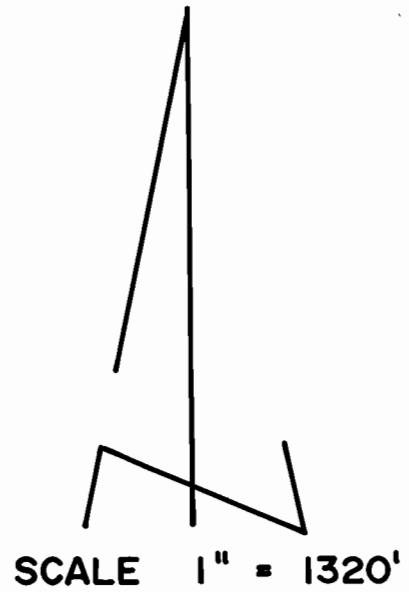


T. 20S., R. 47E., W.M.

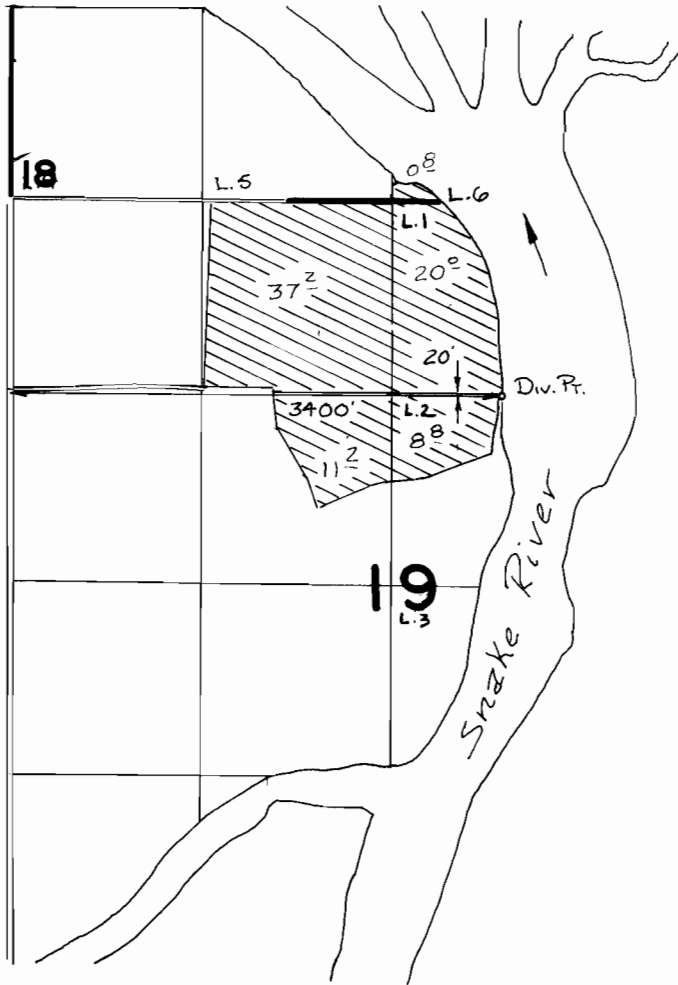

FINAL PROOF SURVEY UNDER

16067
49374

Application No. **68311**... Permit No. **49374**..
IN NAME OF

.....
Surveyed *7-20*..... 19*88*, by *V.H. Church*.....