


T. 38 & 39 S., R. 3 W., W. M.

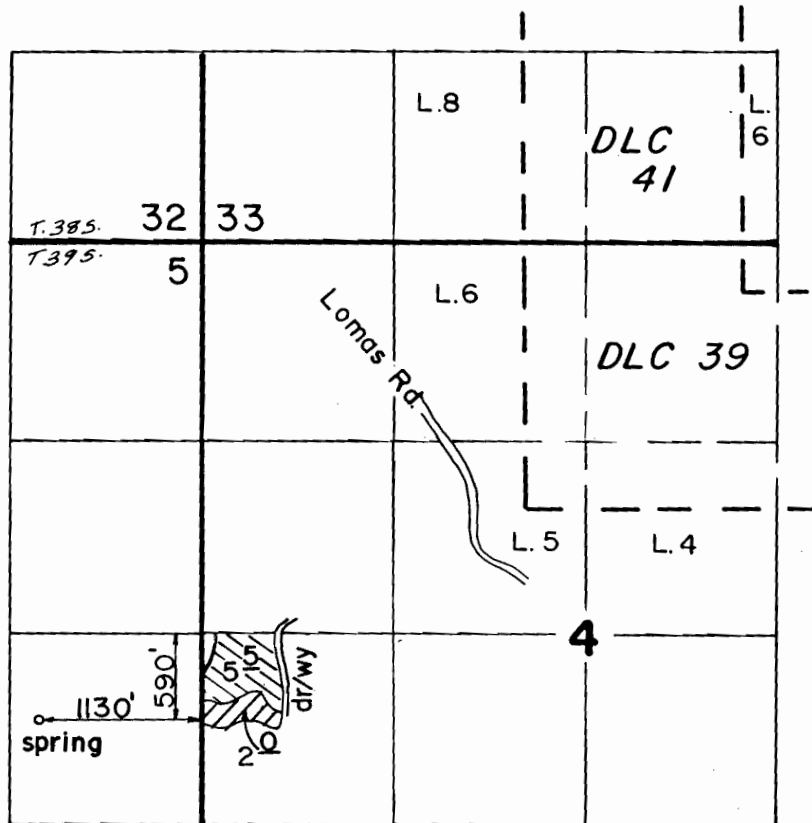

Scale: 1" = 1320'

supplemental



FINAL PROOF SURVEY
UNDER

Application No. 68364 Permit No. 49600.
IN NAME OF

DARRELL.....T.....&/or.....JANICE.....H.....GATH

Surveyed FEB....8... 1988., by B....S....JAMES...