


T. 28 S., R. 13 W., W.M.

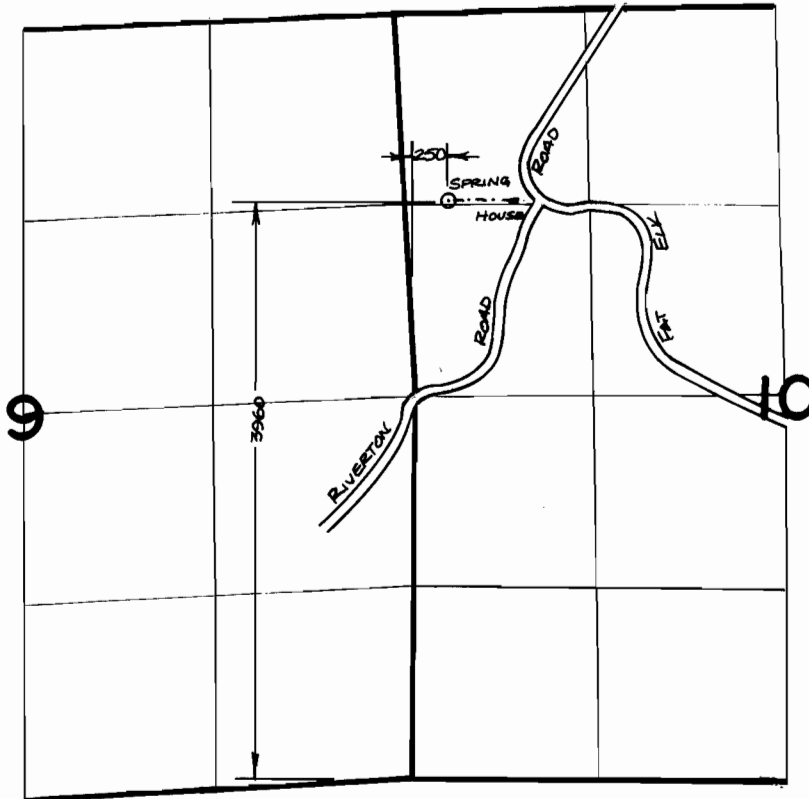

SCALE : 4" = 1 MILE

FINAL PROOF SURVEY UNDER

Application No. ...68365.. Permit No. ...49570.....
IN NAME OF

.....DANNY & RHONDA PEARCE.....

Surveyed ...3/16..... 19.88., by ...M. SCHMORDE.....