


T.13 S., R. 30 E., W.M.

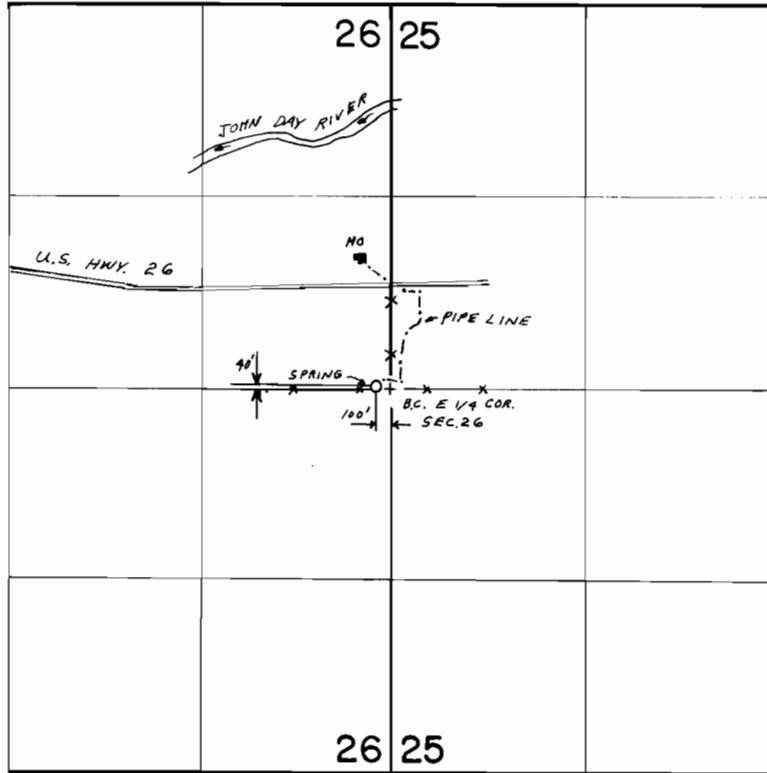

SCALE: 1"=1320'

**FINAL PROOF SURVEY**  
UNDER

Application No. 68366.. Permit No. 49405.....  
IN NAME OF

**FRED AND CHERI MOORE**

Surveyed JUN. 21.. 1988.. by V.L. CHURCH.....