

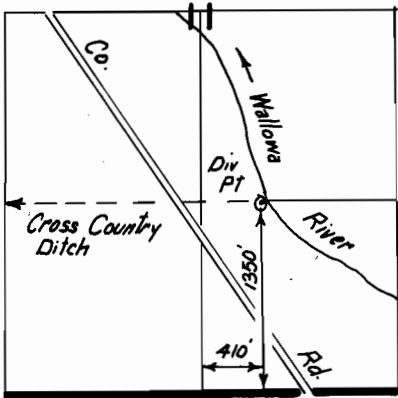


T.1S., R.43E., W.M.

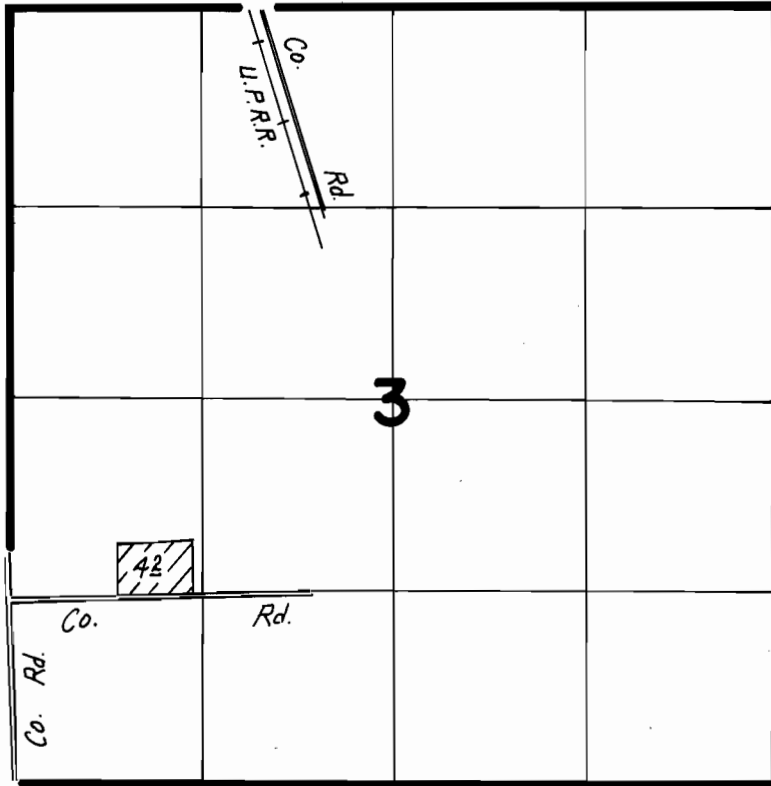

FINAL PROOF SURVEY UNDER

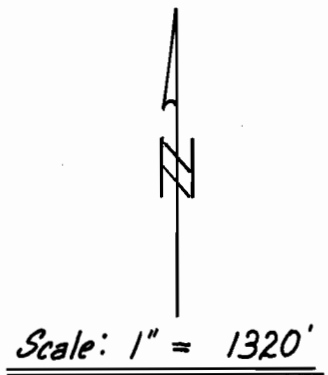

Application No. **68422** Permit No. **49490**
IN NAME OF

LOSTINE CEMETARY DISTRICT

Surveyed **8-9** 19**88**, by **Vern Church**