


T. 30 S., R. 12 W., W.M.

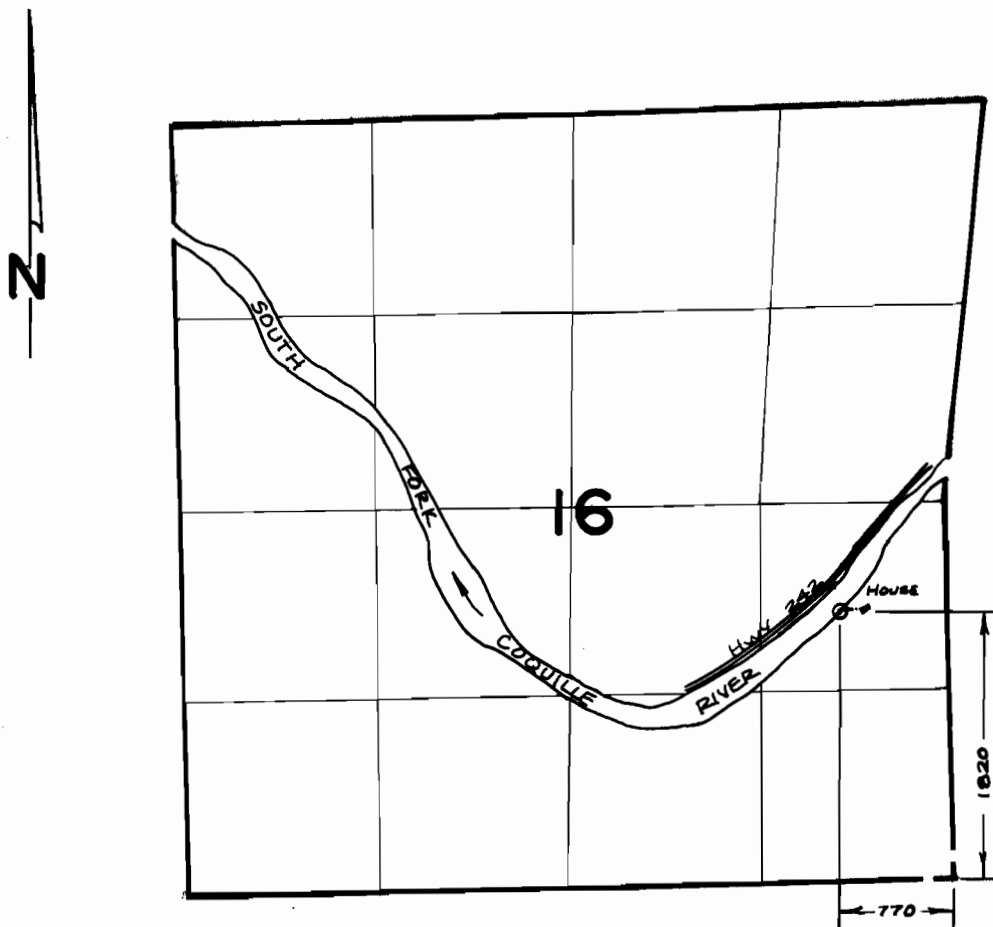

SCALE: 4" = 1 MILE

FINAL PROOF SURVEY UNDER

Application No. ...68544. Permit No. ...49478.....
IN NAME OF

.....**MARVIN R. BARZEE**.....

Surveyed ...7/21..... 1988., by ...M. SCHMORDE...