


49580
65553

T. 40 S., R. 9 E., W.M.

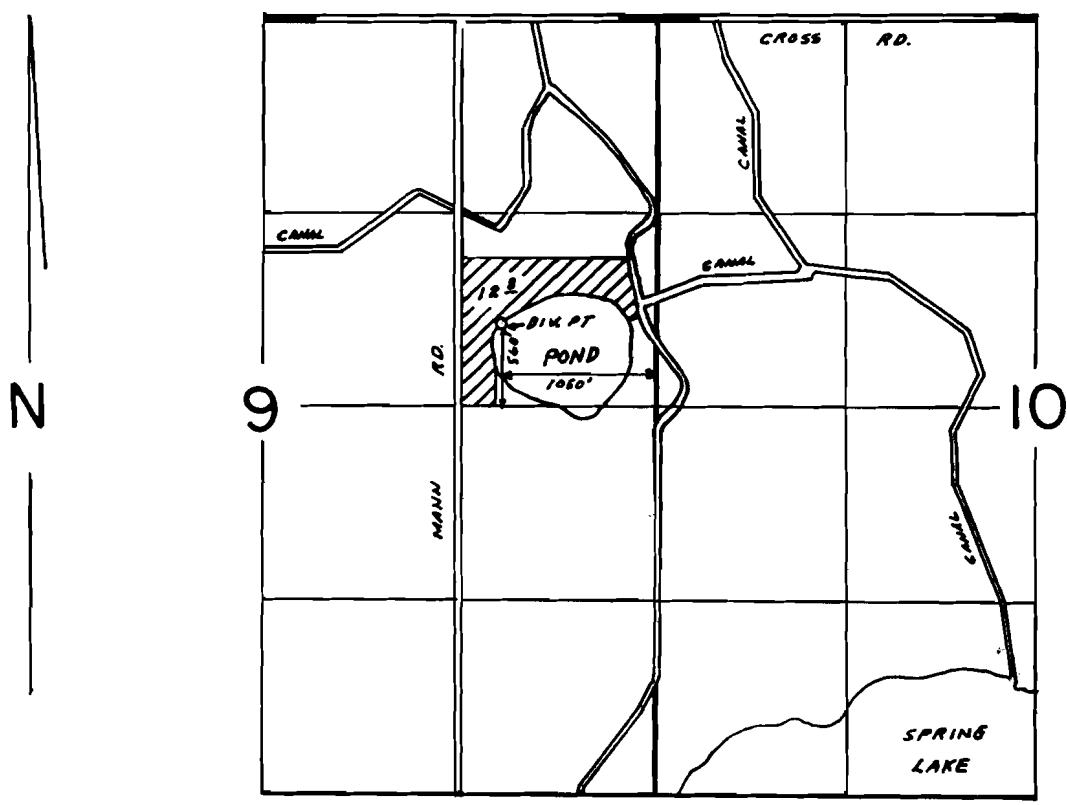

SCALE: 1"=1320'

FINAL PROOF SURVEY UNDER

Application No. 68614... Permit No. 49580!
IN NAME OF

FRANKLIN W. AYRES

Surveyed JUL... 21... 19.88, by B. BISHOP.....

East Ayres Map