


T. 28S., R. 7 & 8 W., W. M.

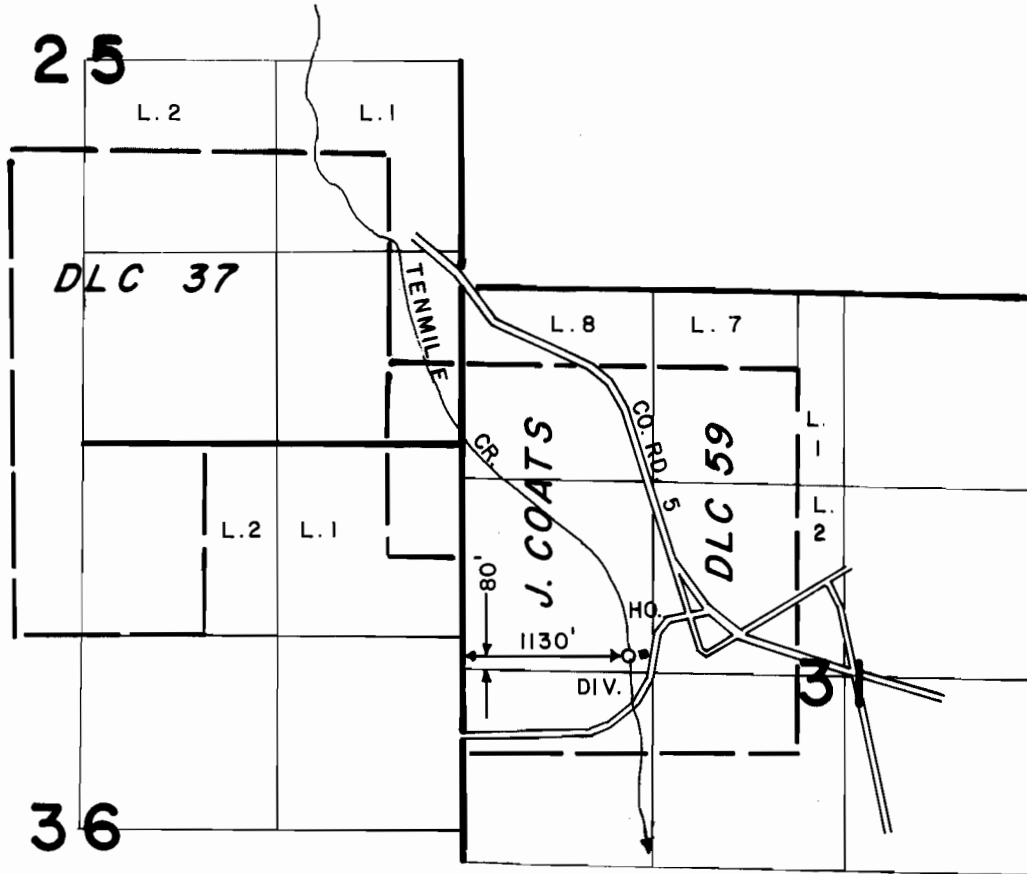

SCALE: 4" = 1 MILE

FINAL PROOF SURVEY
UNDER

Application No. 68765 Permit No. 49756
IN NAME OF

ALFRED R. CENTERS

Surveyed MAY 14, 1988, by J. M. SCHMORDE

