


T. 28 S., R. 13 W., W.M.

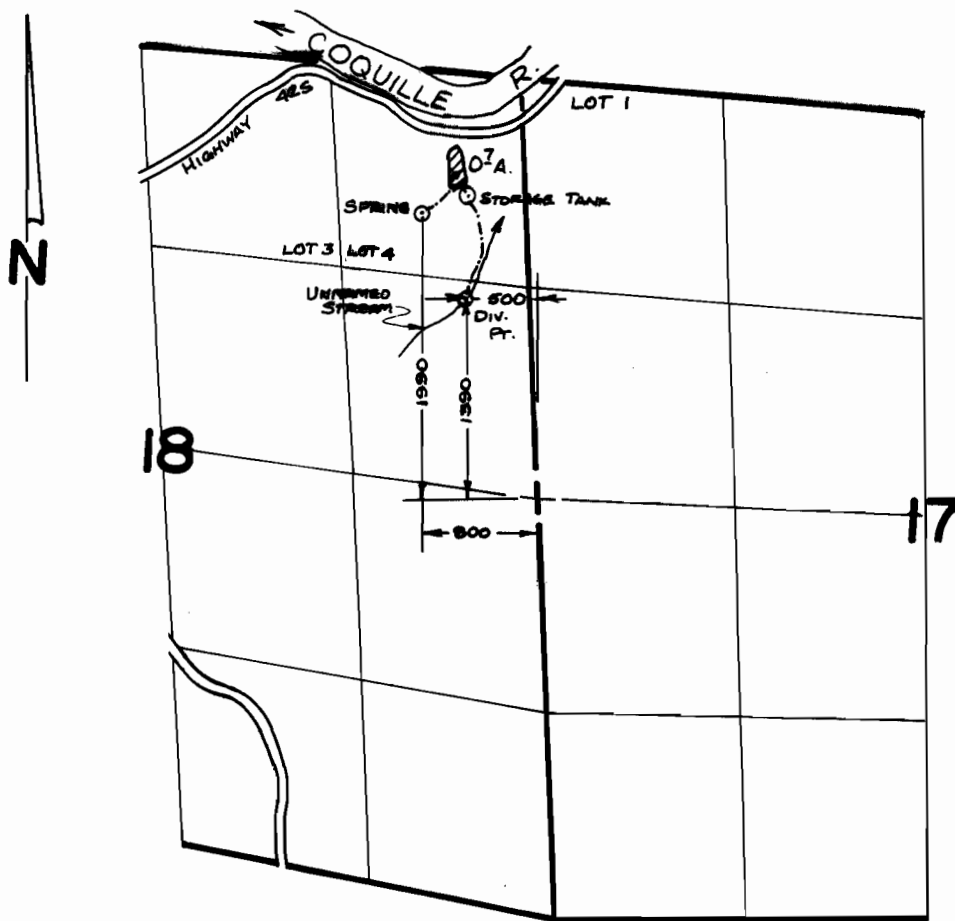

SCALE : 4" = 1 MILE

FINAL PROOF SURVEY UNDER

Application No. ...687.89. Permit No. ...50000....
IN NAME OF

.....**CHARLOTTE ALBERTSON**.....

Surveyed4/19.... 19.88, by ...M.SCHMORDE....