


T. 28 S., R. 4 W., W. M.

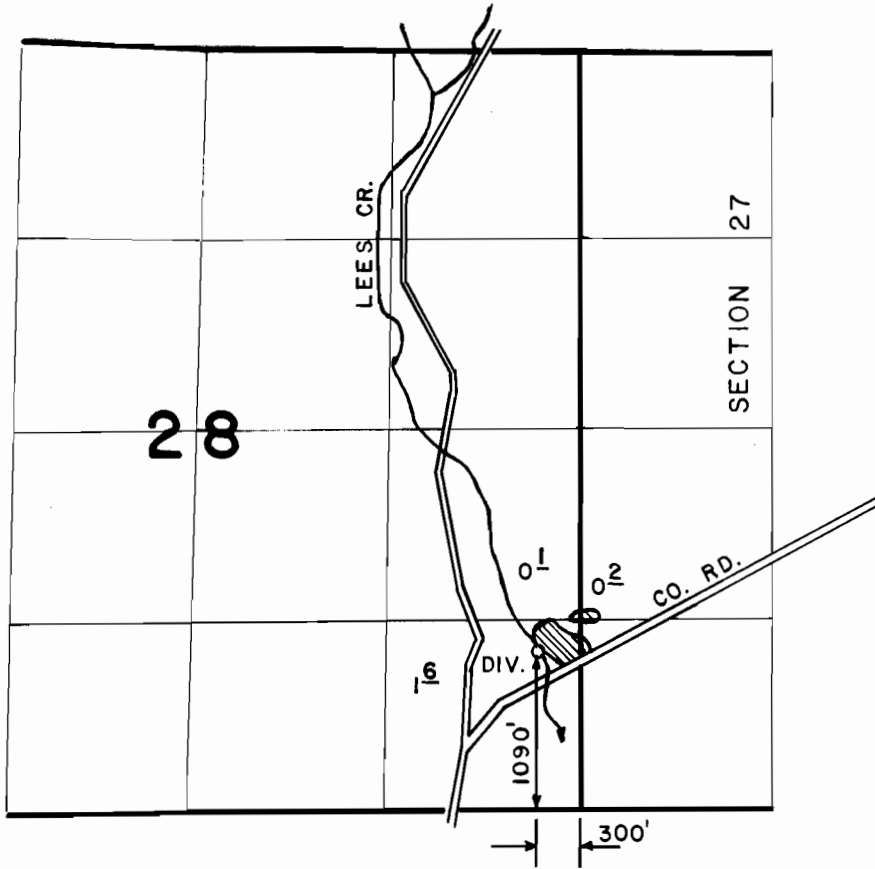

SCALE: 4" = 1 MILE

FINAL PROOF SURVEY
UNDER

Application No. 68839... Permit No. 49774.....
IN NAME OF

PAUL E. MARCUSON

Surveyed AUG. 3..... 1988, by J.M. SCHMORDE.....