




# T. 40S., R. 19 E., W.M.

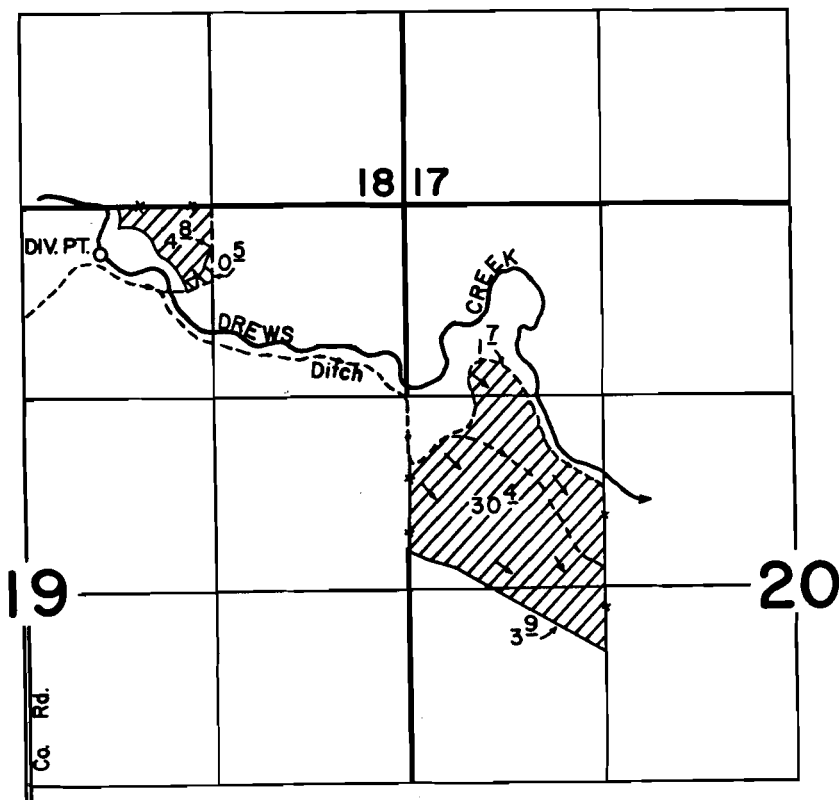

DIV. PT. LOC.: 320' S. & 540' E. FROM N. 1/4 CORNER SECTION 19.

SCALE: 1" = 1320'

## FINAL PROOF SURVEY UNDER

-  Primary
-  Suppl.

Application No. 68842... Permit No. 49927.....  
IN NAME OF

.....CLYDE FENIMORE.....

Surveyed AUG. 16... 1989., by B. W. BISHOP....