


# T. 38 S., R. 4 W., W. M.

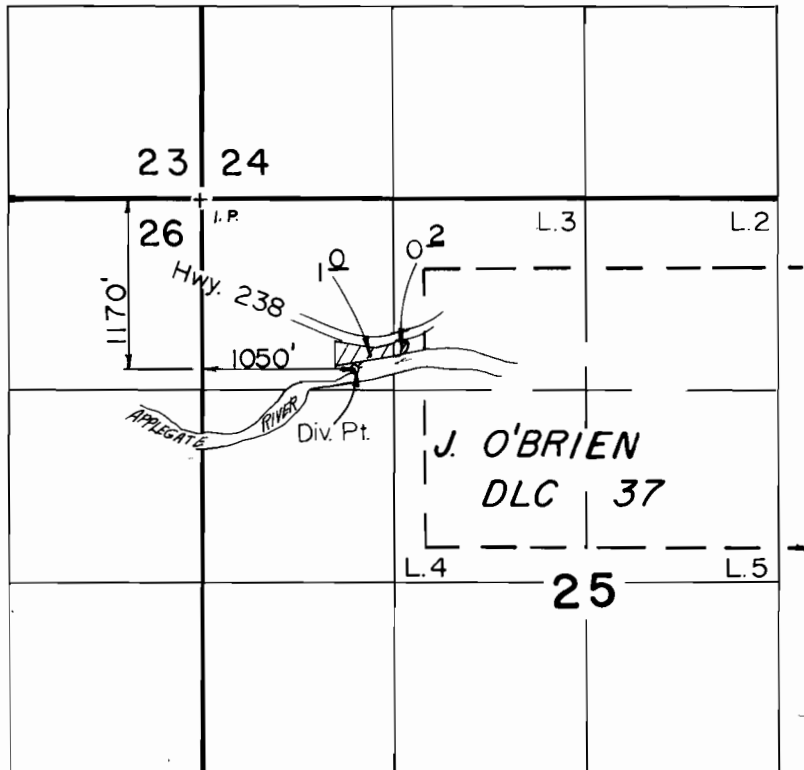

Scale: 1" = 1320'

## FINAL PROOF SURVEY UNDER

Application No. 69010 Permit No. 50025  
IN NAME OF

FRANKLIN D. DRYDEN

Surveyed FEB. 4. 1988, by B. S. JAMES.