


90884

T. 28 S., R. 5 W., W. M.

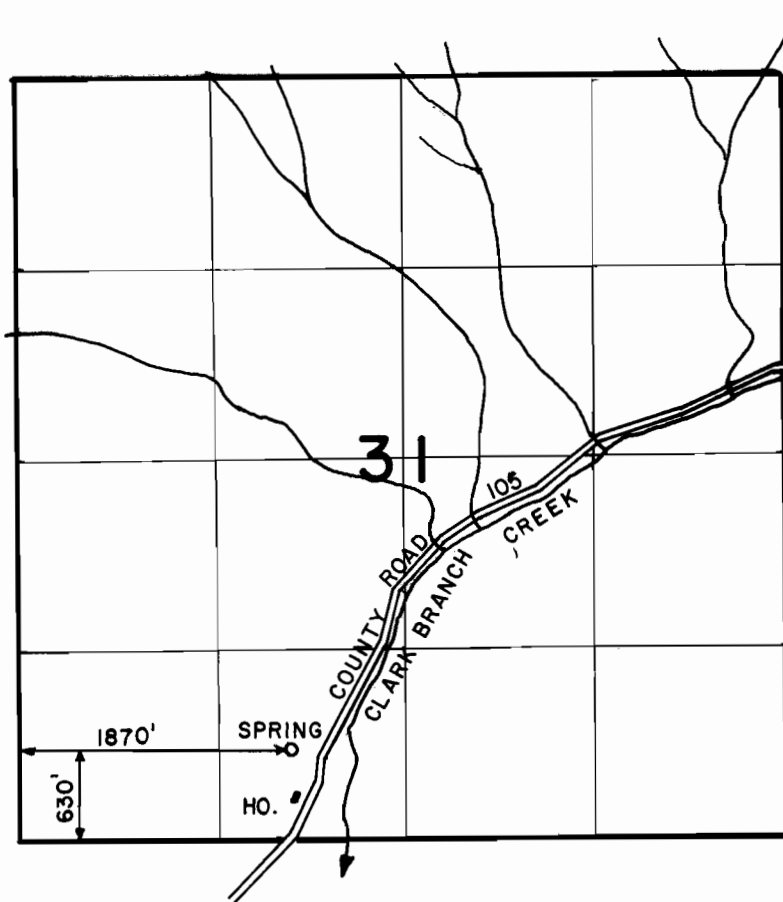

SCALE: 4" = 1 MILE

FINAL PROOF SURVEY
UNDER

Application No. 69089.. Permit No. 50010.....
IN NAME OF

WILLIAM BYRON ROBERTS

Surveyed AUG. 10... 1988., by J. M. SCHMORDE