


T. 24S., R. 33E., W.M.

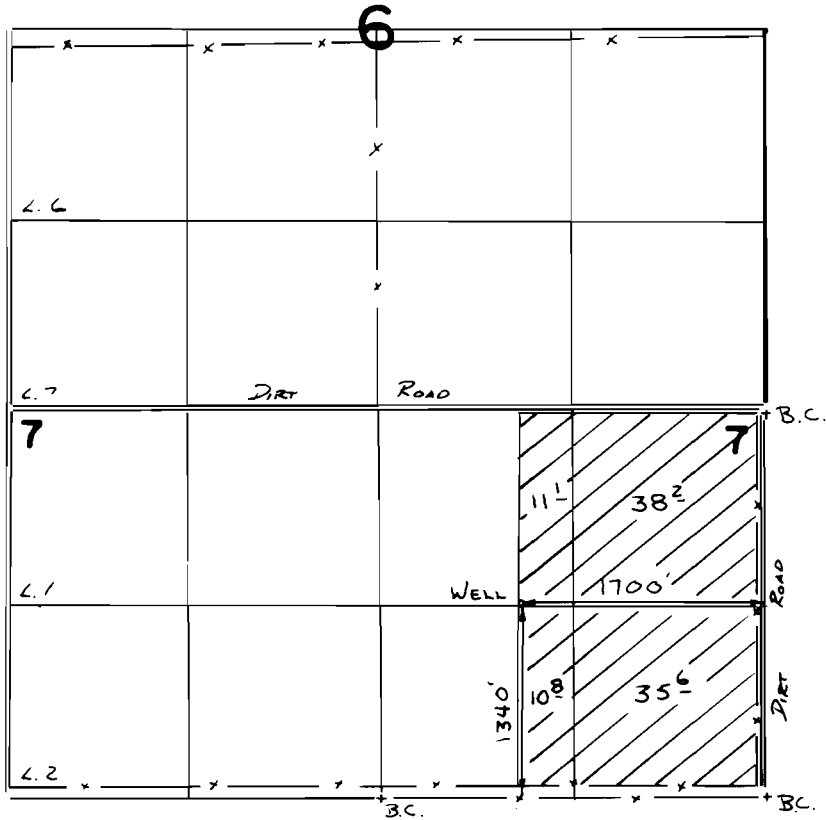

SCALE 1" = 1320'

FINAL PROOF SURVEY UNDER

Application No. **G:5952** Permit No. **G:5748**...
IN NAME OF

.....**DVA**.....

Surveyed **5-6**..... **1988**, by **V.L. Church**.....