G-6065

65568

T.38S., R.8&9E., W.M.

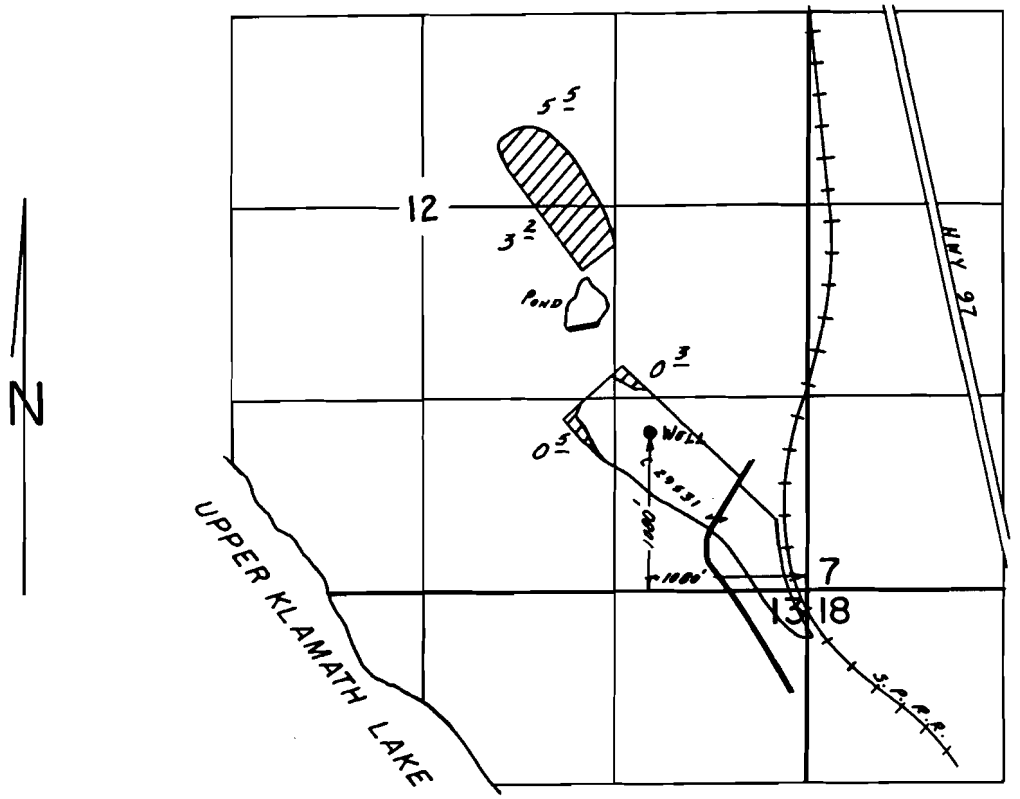

SCALE: 1" = 1320'

FINAL PROOF SURVEY
UNDER

Application No. G-6470. Permit No. G-6065
IN NAME OF

ELSIE P. & D. T. MATTHEWS

Surveyed Oct. 6 19 88, by R.W. BISHOP

1/25/89
BWB

41035-179-181D