


T.19S., R.19E., W.M.

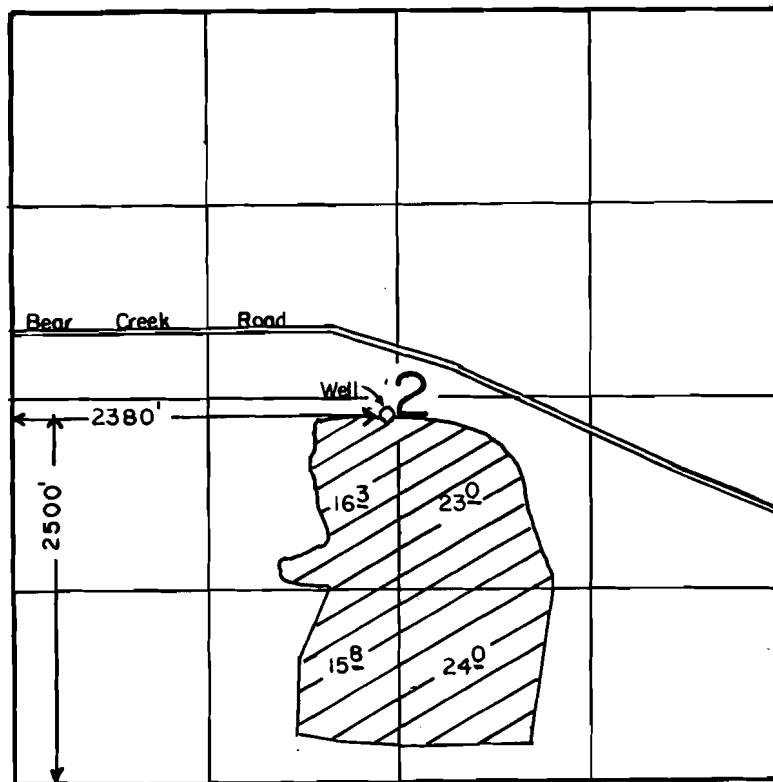

SCALE: 1" = 1320'

FINAL PROOF SURVEY

UNDER

Application No. G-6814... Permit No. G-6317.....
IN NAME OF

Cert. # 65569

RAY RICKMAN

Surveyed MAY 18 1989, by B.W. BISHOP.....