




T.14&15S., R.13E., W.M.

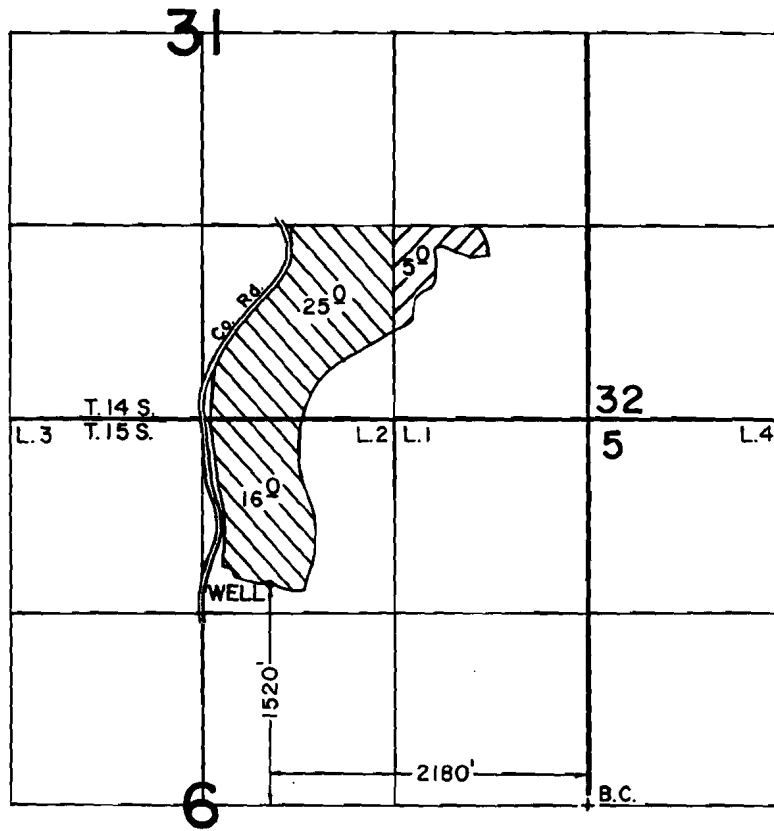

SCALE: 1" = 1320'

FINAL PROOF SURVEY
UNDER

 Primary
 Supp'l.

Application No. G-6845 Permit No. G-5697....
IN NAME OF

..... PHILIP DAHL

Surveyed JUNE 27, 1989., by B.W. BISHOP.....

Cert. # 65570