


T. 38 S., R. 5 W., W. M.

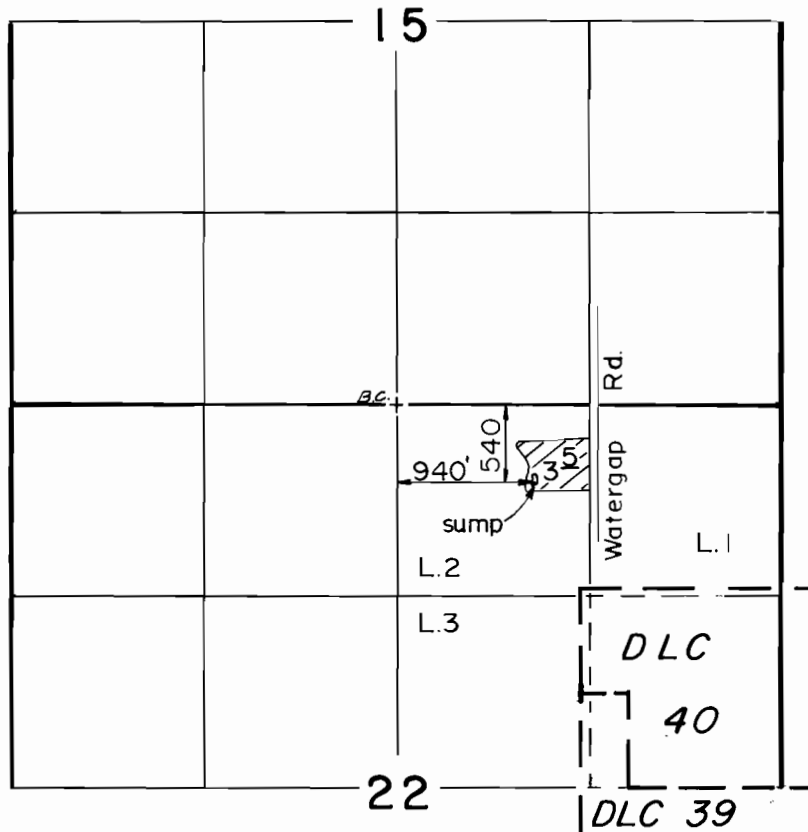

Scale: 1" = 1320'

FINAL PROOF SURVEY
UNDER

Application No. G-7152 Permit No. G-6599
IN NAME OF

EUGENE C. SIMS

Surveyed AUG. 16 1988, by B. S. JAMES