


T.1N. R.15E. W.M.

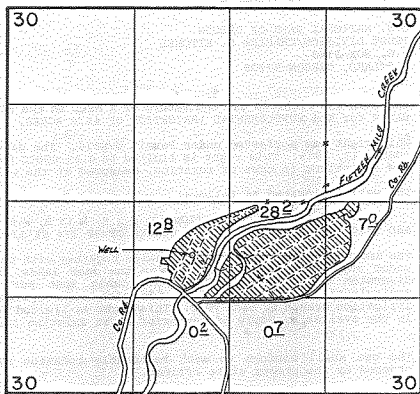

WELL Loc. 140' S + 1830' W From The NE Cor. NW 1/4 SE 1/4 Sec. 30

FINAL PROOF SURVEY
UNDER

Application No. G-9368. Permit No. G-8834.
IN NAME OF
U. S. NATIONAL BANK OF OREGON, TRUSTEE, &
CHARLES C. KITCHEL

Surveyed Nov. 14, 1984, by T. Paul