




T. 27 S., R. 15 E., W.M.

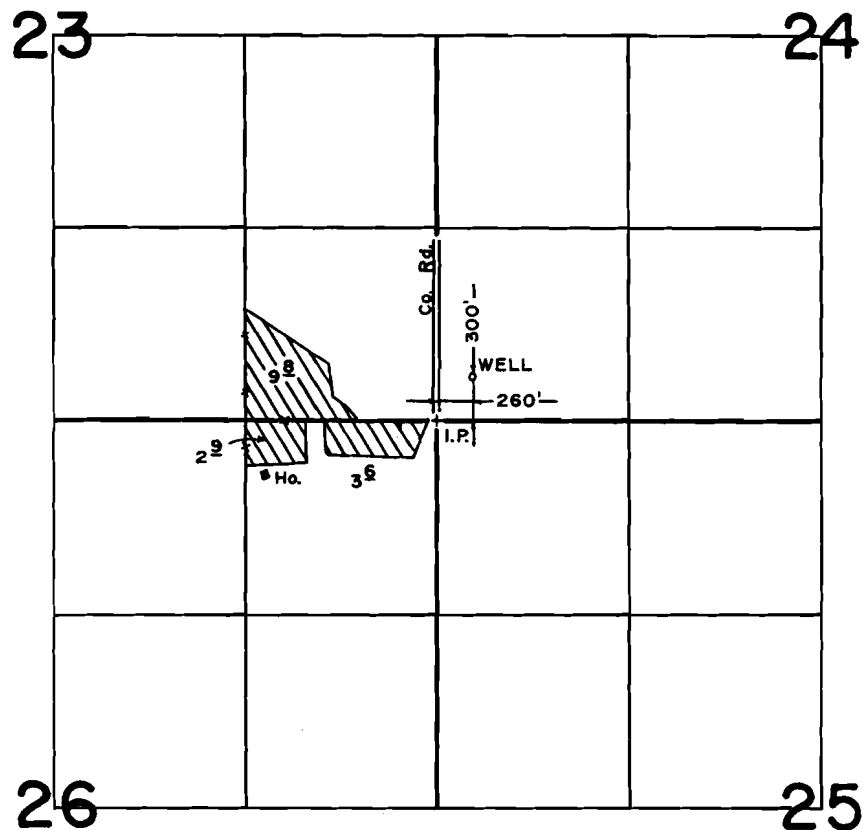

SCALE: 1" = 1320'

FINAL PROOF SURVEY
UNDERApplication No. G-10998 Permit No. G-10174
IN NAME OF.....**DARREL G. BOWEN**.....

Surveyed JULY 13, 1989, by B.W. BISHOP.....