




T. 36 S., R. 1 W., W.M.

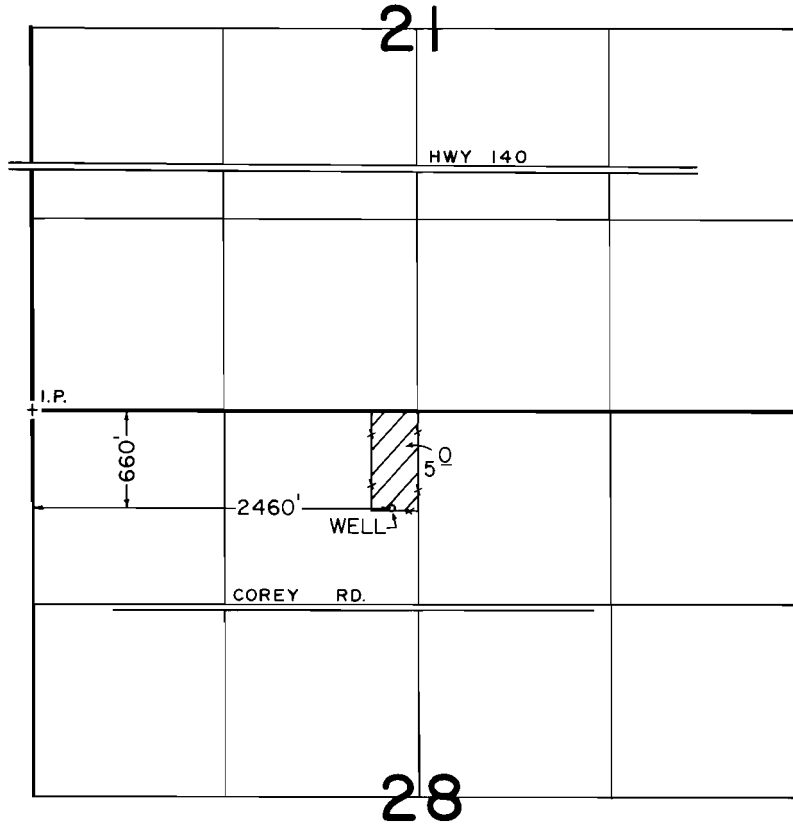

SCALE: 1" = 1320'

FINAL PROOF SURVEY
UNDER

Application No. G-11046 Permit No. G-10206
IN NAME OF

M. JoANN MAST

Surveyed MAY 30, 1989, by B.S. JAMES