




T.28S.,R.14E.,W.M.

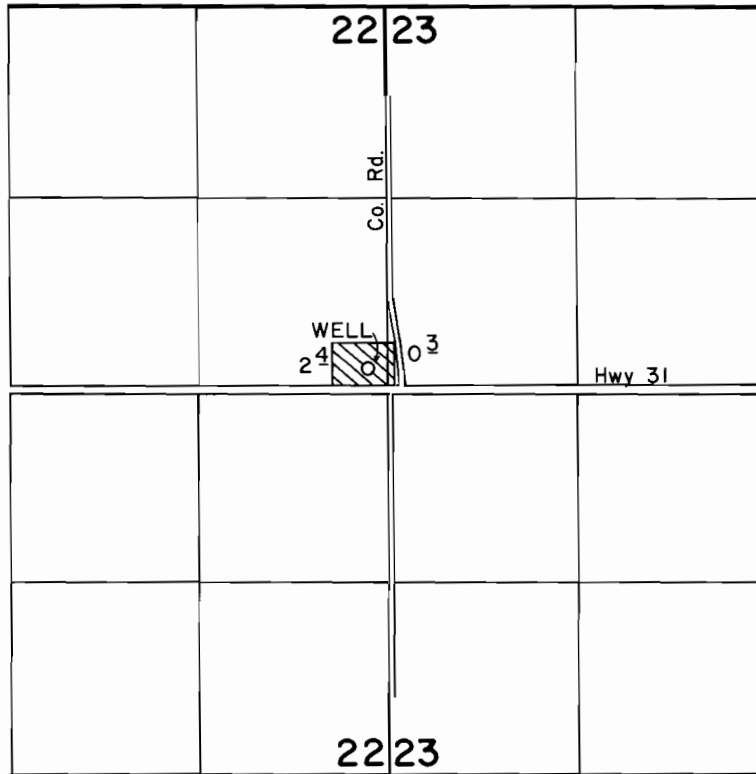

WELL LOC: 150' N. & 150' W. FROM THE E.1/4 CORNER SEC.22

SCALE: 1" = 1320'

FINAL PROOF SURVEY
UNDER

Application No. G-11204 Permit No. G-10827...
IN NAME OF

LAKE COUNTY CEMETERY MAINTENANCE DISTRICT

Surveyed JULY 18, 1989, by B.W. BISHOP...