


G-10807
65578

T.38S., R.11 1/2E., W.M.

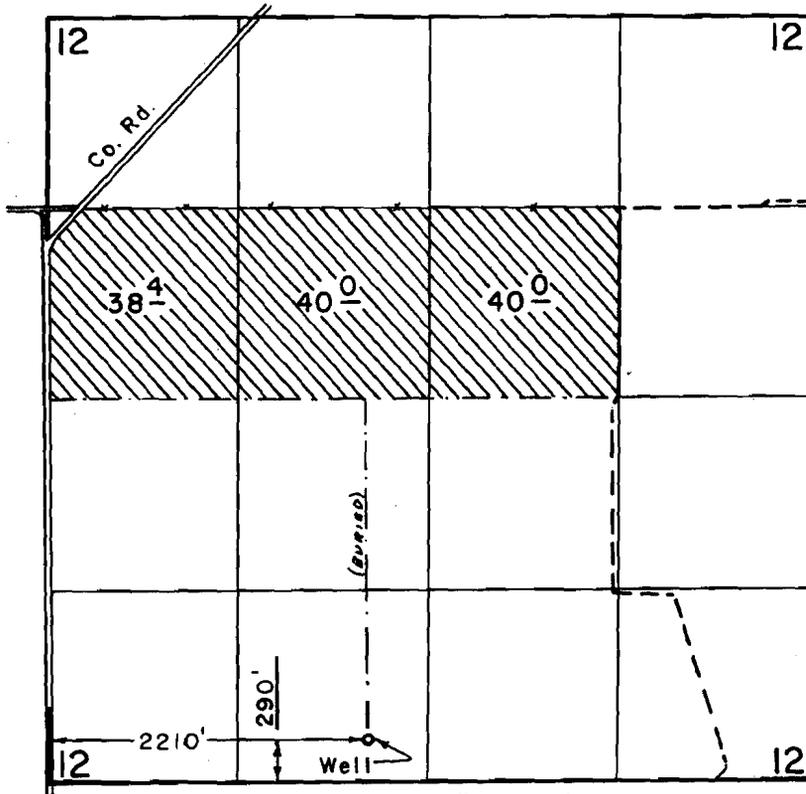


SCALE: 1" = 1320'

East Creek & Young Valley ditches

"THIS MAP IS FOR THE PURPOSE OF IDENTIFYING THE LOCATION OF THE WATER RIGHT ONLY AND IS NOT INTENDED TO PROVIDE LEGAL DIMENSIONS OR LOCATION OF PROPERTY OWNERSHIP LINES"

FINAL PROOF SURVEY UNDER

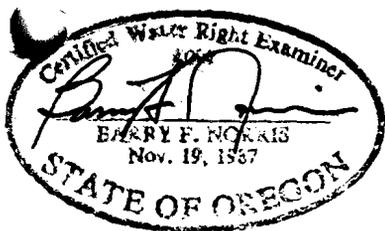

Application No. G-11794. Permit No. G-10807...

IN NAME OF
STATE OF OREGON
WATER RESOURCES DEPARTMENT

Surveyed Oct. 3, 1988, by B.W. BISHOP.....

1/22/89
BWB
CNO-3JJ-137