T.3S., R.2W., W.M.

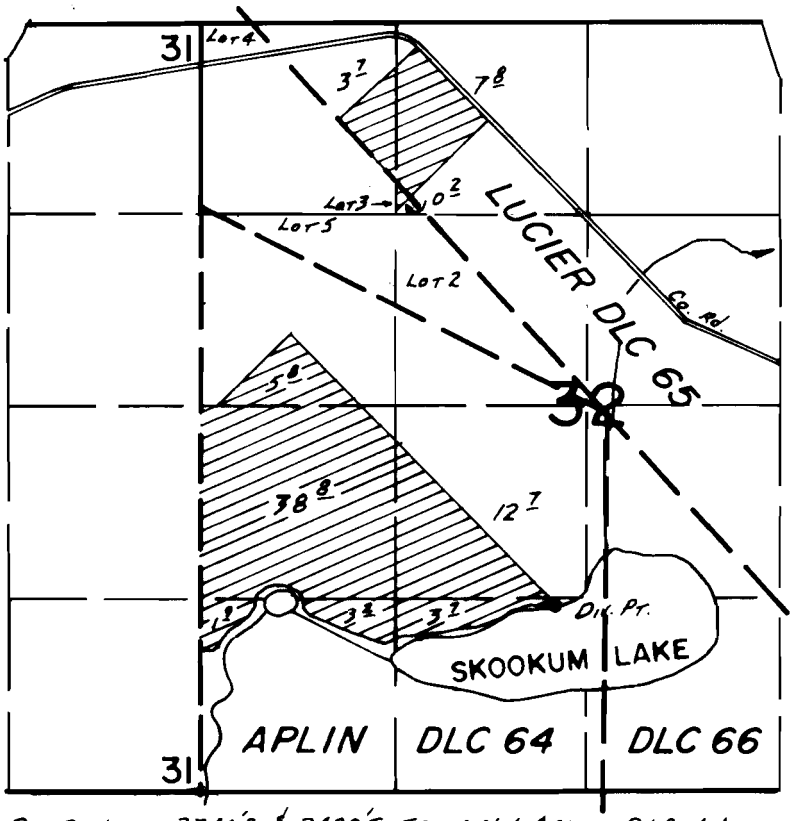

Div. Pt. Loc: 2740'S. & 2420'E. FROM NW APLIN DLC 64

FINAL PROOF SURVEY

UNDER

Application No. 53808 **Permit No.** 47090

IN NAME OF

HILLER FARMS

Surveyed Sept. 6 **19**83, **by** L.M. TOLL

DFN-6LL-126 BWB