


T. 36S., R. 7W., W. M.

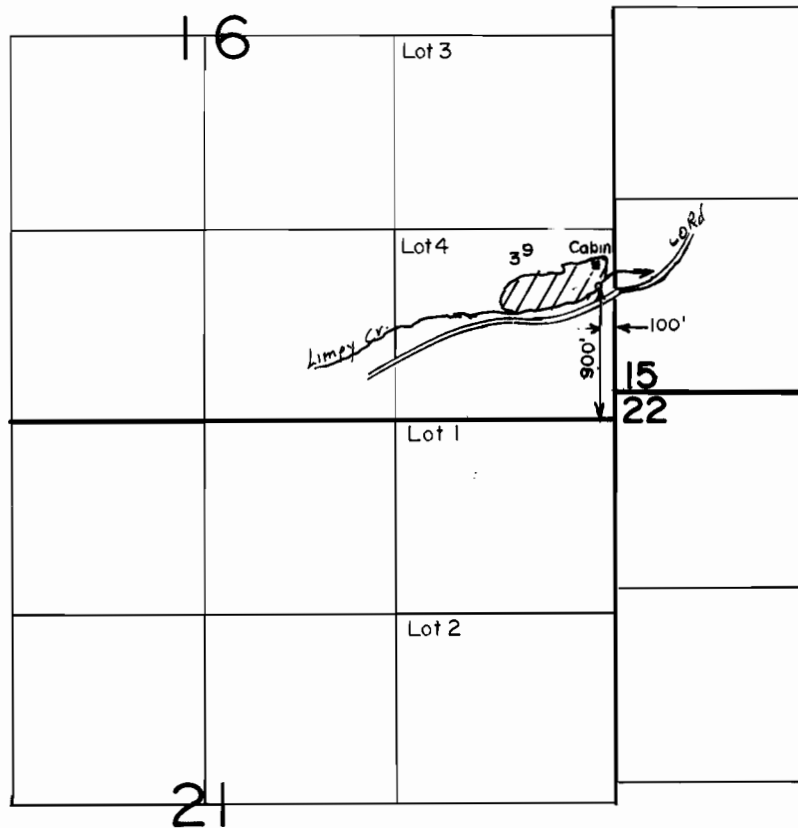

SCALE: 1"=1320'

**FINAL PROOF SURVEY**  
UNDER

Application No. 5.7.4.3.2.. Permit No. 4.3.2.6.7.....  
IN NAME OF

.....**Louise**.....**LaBarbara**.....

Surveyed **MAY 25**... **1989**., by **B.S. JAMES**.....