


T. 37 S., R. 4 W., W. M.

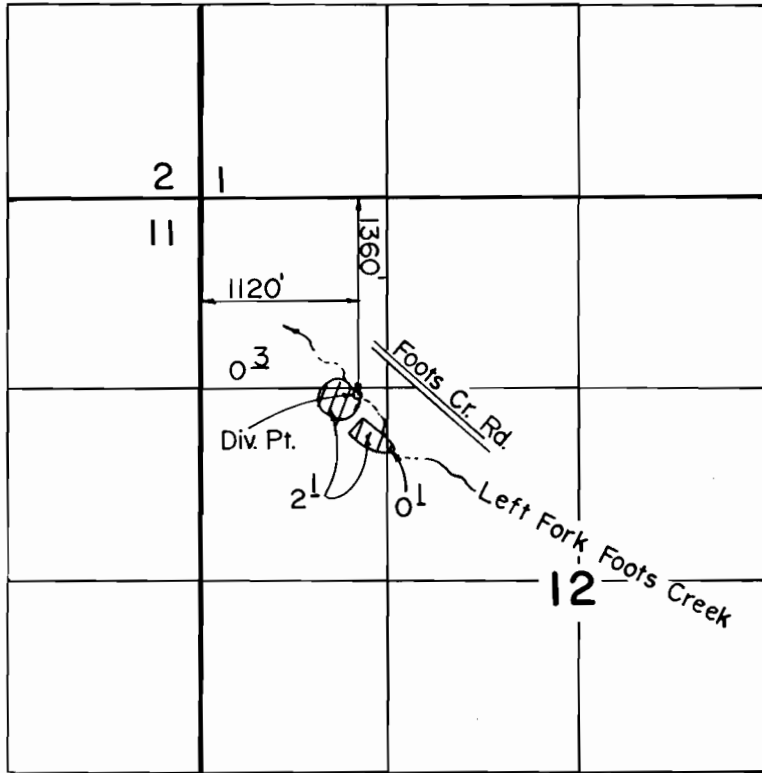

Scale: 1" = 1320'

FINAL PROOF SURVEY
UNDER

Application No. 57499. Permit No. 43276...
IN NAME OF

.....EDWIN.....A.....SHELBY.....

Surveyed AUG. 30. 1988., by B. S. JAMES...