

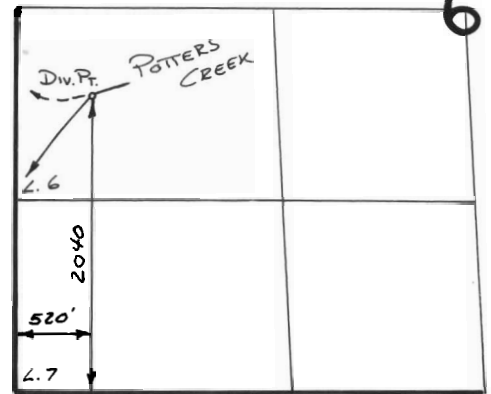


T. 4S., R. 41E., W.M.

6

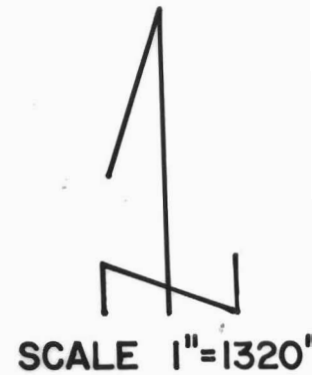

T. 4S., R. 40E., W.M.

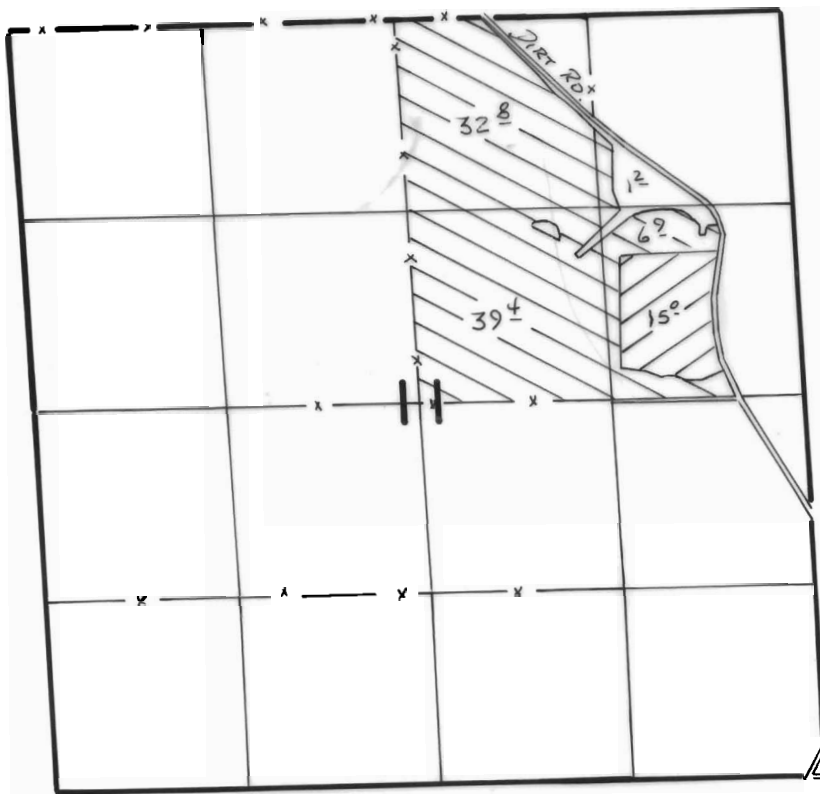

FINAL PROOF SURVEY

UNDER

Application No. **57577** Permit No. **43328**
IN NAME OF

LLOYD D. REAGAN

Surveyed **2-9** 19**88**, by **V.L. Church**