


# T. 38 S., R. 5 W., W. M.

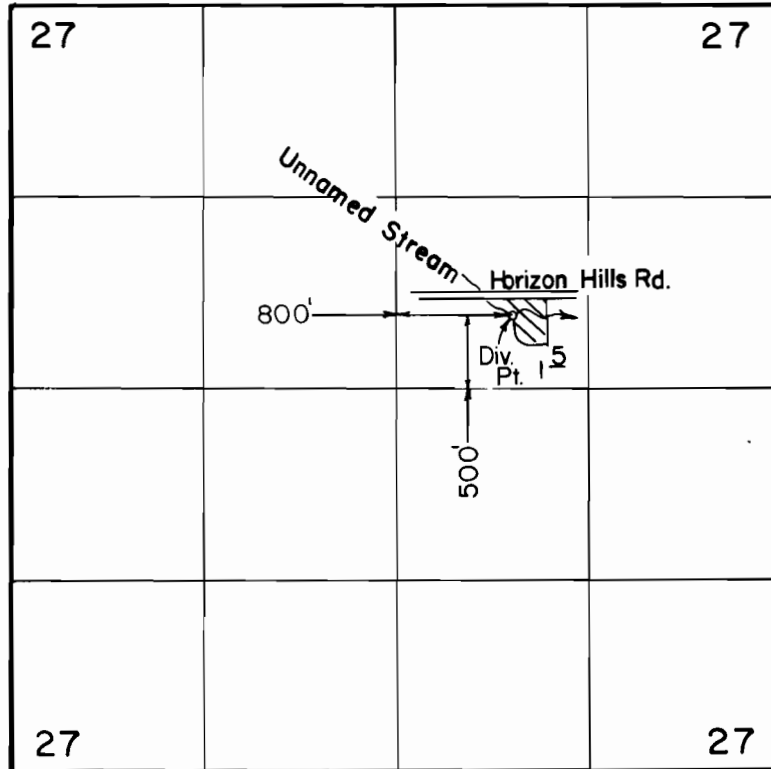

Scale: 1" = 1320'

## FINAL PROOF SURVEY UNDER

Application No. 57681.. Permit No. 43467....  
IN NAME OF

GEORGE...R...&...BERNICE...ZETTLMAIER

Surveyed AUG., 9.... 19.88., by B...S...JAMES....