


T. 22 S., R. 6 W., W.M.

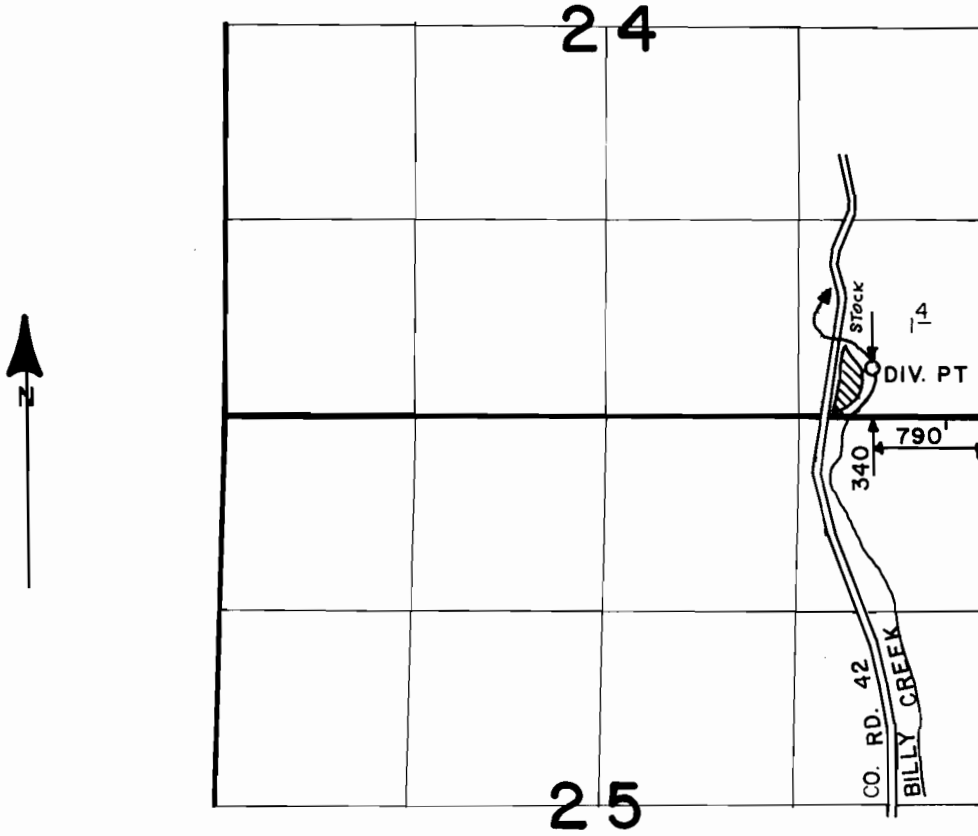

SCALE: 4" = 1 MILE

**FINAL PROOF SURVEY**  
UNDER

Application No. 57.791.... Permit No. 435.45.....  
IN NAME OF

..... **NELL PATTEN** .....

Surveyed AUG. 2..... 1988., by J. M. SCHMORDE.