


T.25S, R.12 W., W.M.

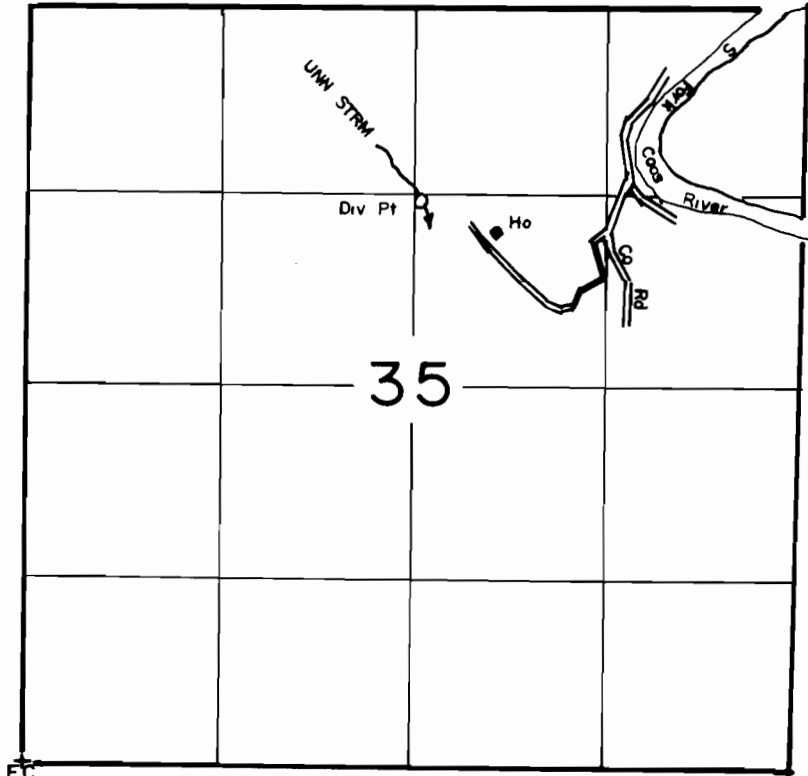

FC DIV PT LDC 1300' N @ 20' E FROM CENTER 1/4 CORNER OF SECTION 35

SCALE: 1" = 1320'

FINAL PROOF SURVEY
UNDER

Application No. 5.8.0.5.4.. Permit No. 43905.....
IN NAME OF

BART A WIRTH

Surveyed JULY...11... 1989., by J.M. SCHMORDE.....