


T.32S., R.14W., W.M.

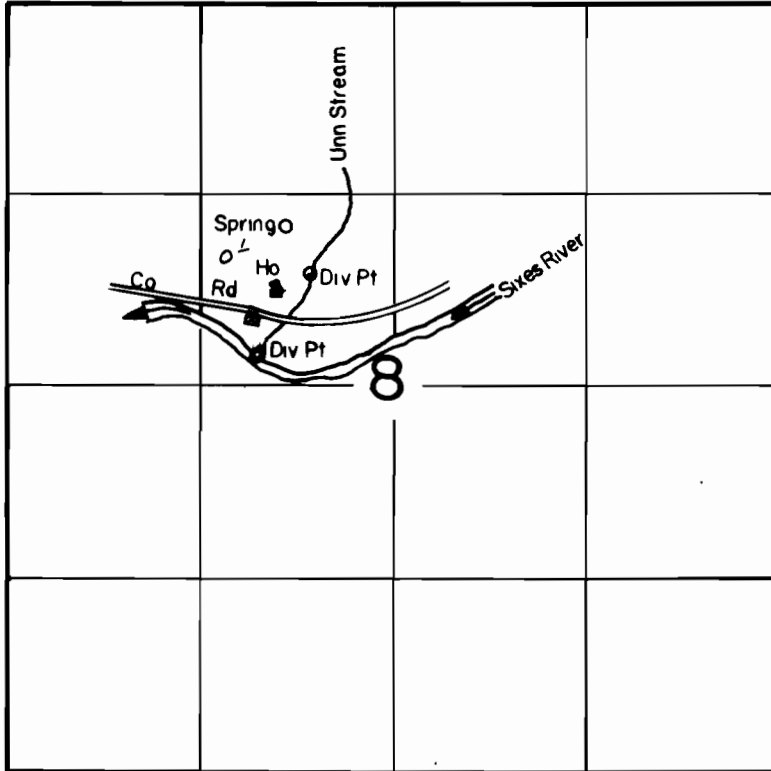

Spring Loc 1100' N & 750' W - Unn Strm Div Pt Loc 750' N & 550' W - Sixes River Div Pt Loc 200' N & 900' W - All From Center 1/4 Corner Of Section 8

SCALE: 1" = 1320'

FINAL PROOF SURVEY
UNDER

Application No. 58086.. Permit No. 43202.....
IN NAME OF

CHARLIE H. CREW.....

Surveyed JULY 29... 1989.., by B.S. JAMES.....