


P-46920
C-65580

T.13S., R.31E., W.M.

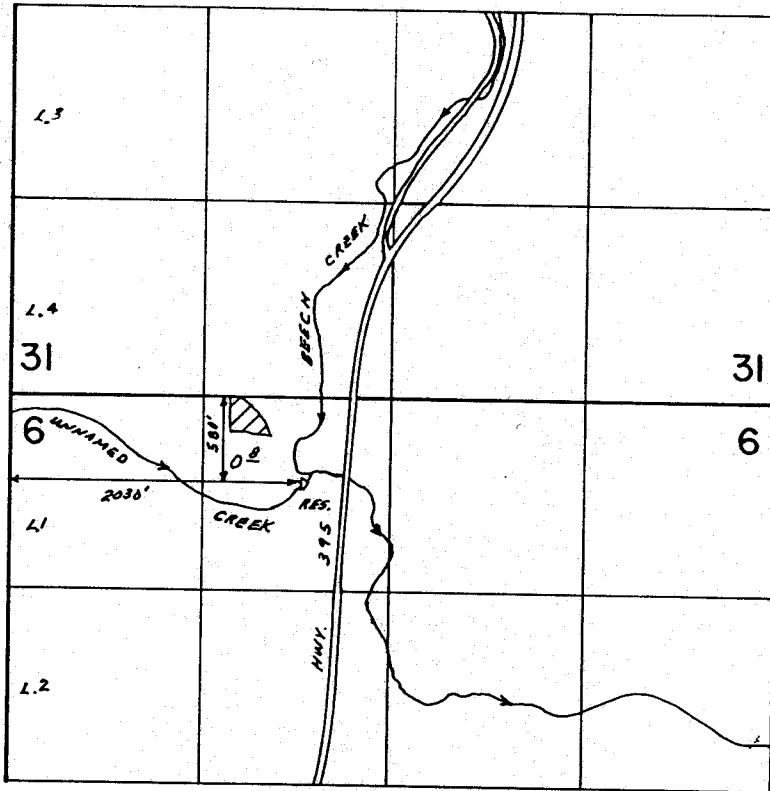

SCALE: 1"=1320'

PERMIT 44612 PRIMARY

PERMIT 46920 SUPPLEMENTAL STORED WATER ONLY

FINAL PROOF SURVEY

UNDER

59359

44612

R63312

R8478

Application No. 63313 Permit No. 46920

IN NAME OF

WILLIAM H. & YVONNE I. DOTSON

Surveyed JUN. 16. 1988., by V.L. CHURCH.....