
90684

T. 35 S., R. 14 W., W. M.

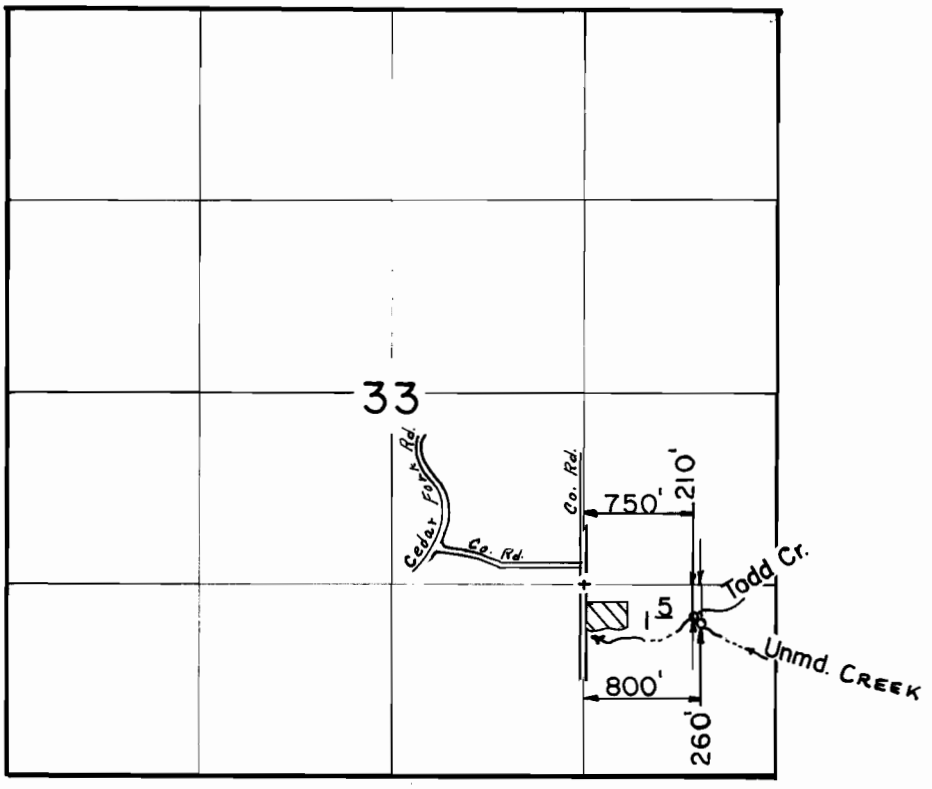

Scale: 1" = 1320'

FINAL PROOF SURVEY
UNDER

Application No. 61328 Permit No. 46506
IN NAME OF

GARLAND S. & JOYCE I. HILL

Surveyed JUL. 25. 1988., by B. S. JAMES

41015-180-39R LMJ
4/89