


T. 1S., R. 43E., W.M.



T. 1S. R. 43E. W.M.

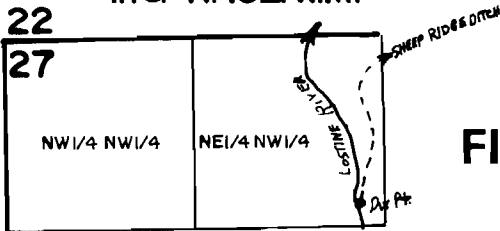

SCALE: 1"=1320'

FINAL PROOF SURVEY
UNDER

DIV PT LOC 1200' S & 120' W FROM NW1/4
CORNER SEC 27

Application No. 61704... Permit No. 46000.....
IN NAME OF

SYLVANUS J. & ALETA M. NEAL

Surveyed AUG 9..... 1988., by V.L. CHURCH.....