


T. 37 S., R. 5 W., W. M.

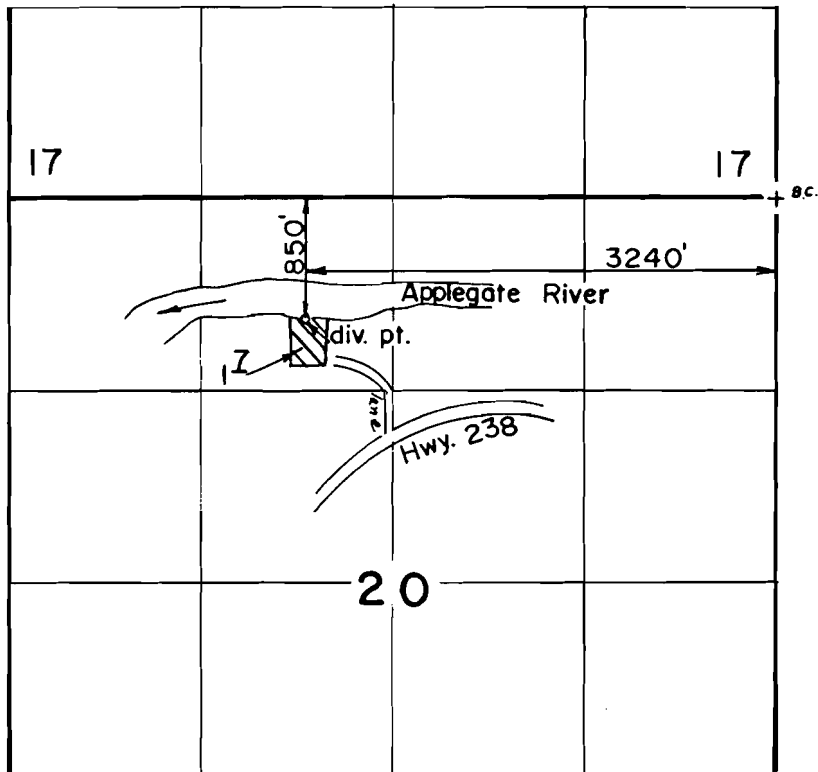

Scale: 1" = 1320'

FINAL PROOF SURVEY

UNDER

61818 46015

Application No. 61819 Permit No. 46016

IN NAME OF

GERALD D. PANKS

Surveyed APR. 4 19.88, by L. M. JOACHIMS