


T. 37 & 38 S., R. 6 W., W. M.

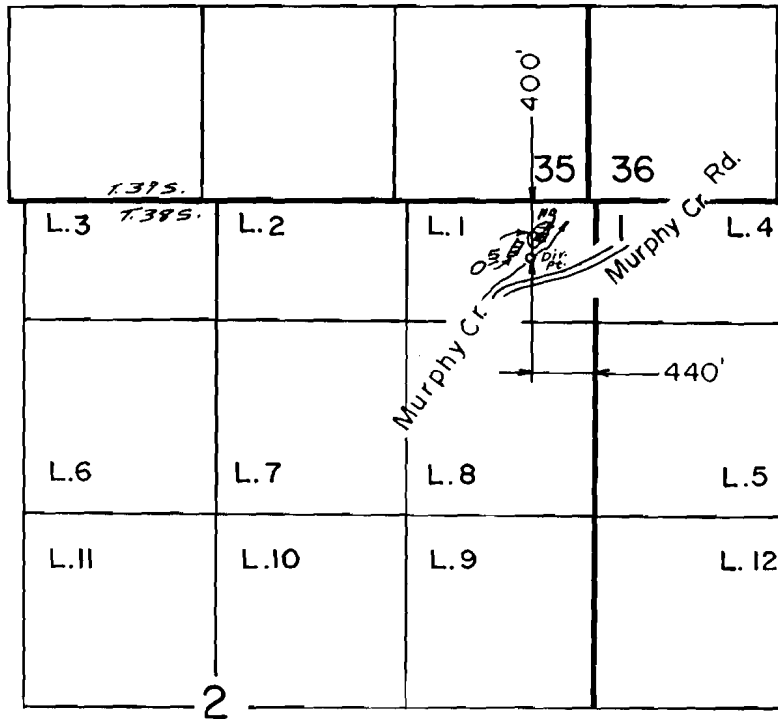

Scale: 1" = 1320"

FINAL PROOF SURVEY
UNDER

Application No. 61835 Permit No. 46134
IN NAME OF

BUCK N. BAKER

Surveyed MAY 24, 1988, by B. S. JAMES