
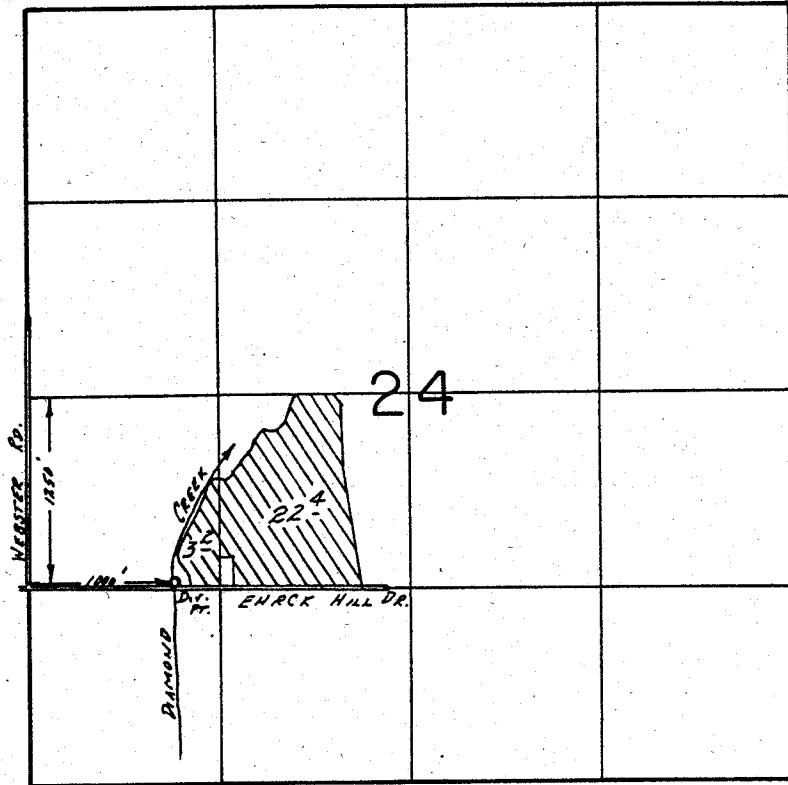


T.2N., R.10E., W.M.

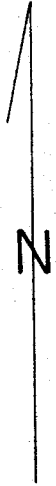

SCALE: 1" = 1320'

FINAL PROOF SURVEY
UNDER

Application No. 62037... Permit No. 46314.....
IN NAME OF

...M. GOE & SON, INCORPORATED.

Surveyed July 12... 19.88, by Z. F. SALEH.....

4/20/89
27-87-SE 1/4