


T. 38 S., R. 4 W., W. M.

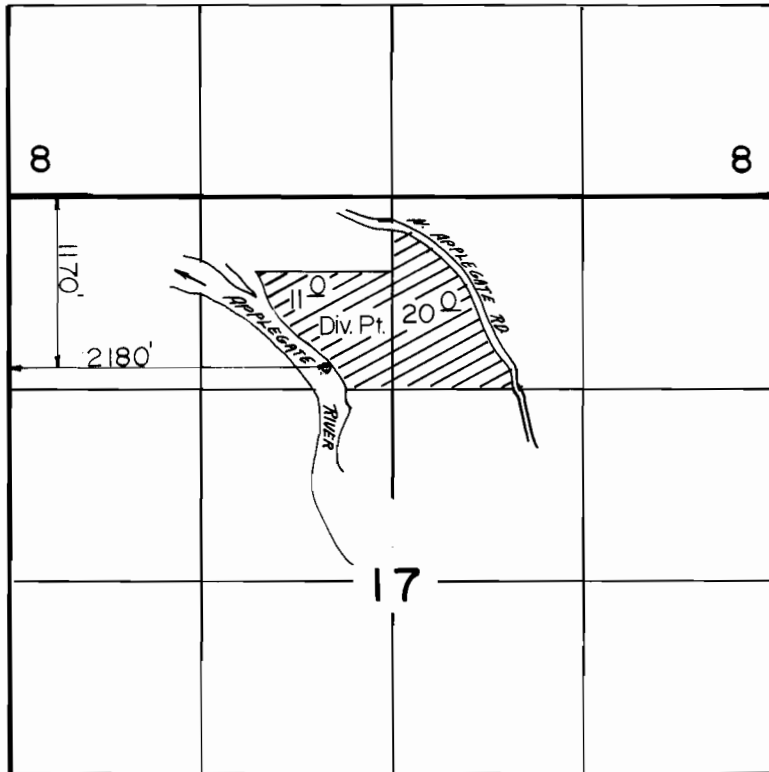

Scale: 1" = 1320'

**FINAL PROOF SURVEY**  
UNDER

Application No. 62174.. Permit No. 46484..  
IN NAME OF

B. W. BIXLER & JANET ENOS

Surveyed FEB. 9. 1988., by B. S. JAMES..