
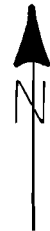


T. 32 S., R. 5 W., W. M.

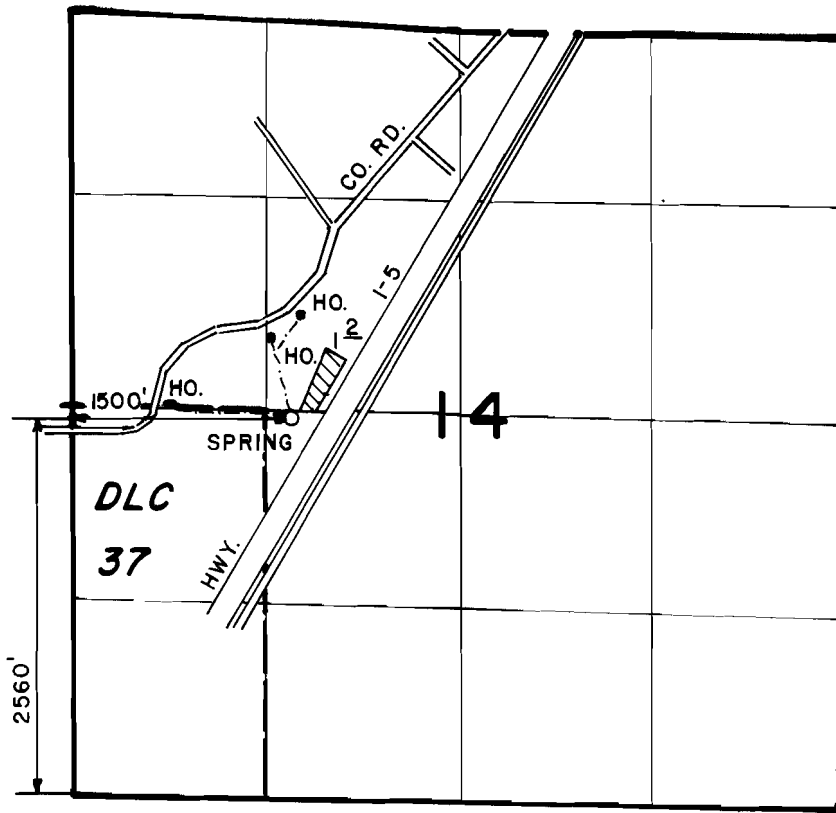

SCALE: 4" = 1 MILE

FINAL PROOF SURVEY
UNDER

Application No. 62356... Permit No. 46513.....
IN NAME OF

FRANK AND DORIS ELST

Surveyed JULY 14, 1988., by J. M. SCHMORDE..