


T. 2 N., R. 10 E., W.M.

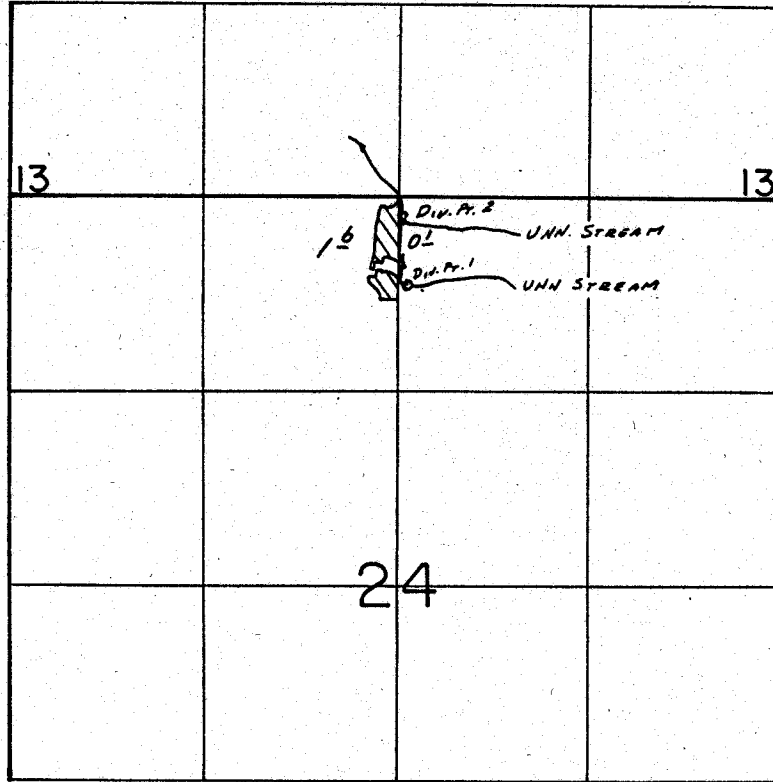

DIV. PTS. LOC: 590'S. & 70'E. & 120'S. & 20'E., BOTH FROM N 1/4 CORNER SEC. 24.

SCALE: 1" = 1320'

**FINAL PROOF SURVEY**  
UNDER

Application No. 62428. Permit No. 47216.....  
IN NAME OF

.....**CHERYL YASUI SPARKS**.....

Surveyed July 12... 1988, by Z.F. SALEH.....

4/28/89  
JWS  
27-87-SE 1/4