


T. 37 S., R. 5 W., W. M.

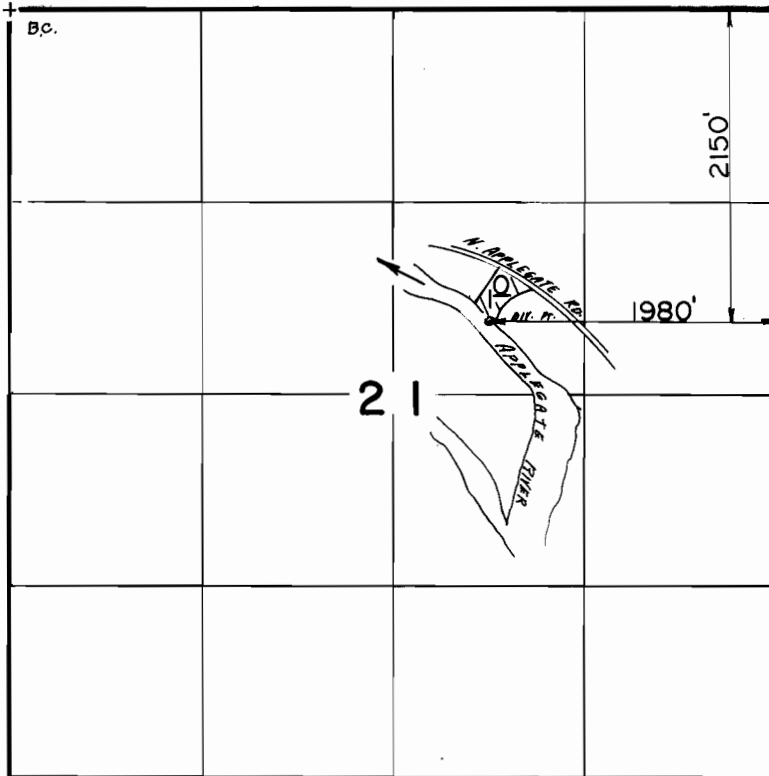

Scale: 1" = 1320'

**FINAL PROOF SURVEY**  
UNDER

Application No. 64944 Permit No. 47595  
IN NAME OF

DOROTHY CATHEY

Surveyed AUG. 23. 1988., by B. S. JAMES.